


T. 6 S., R. 4 W., W.M.

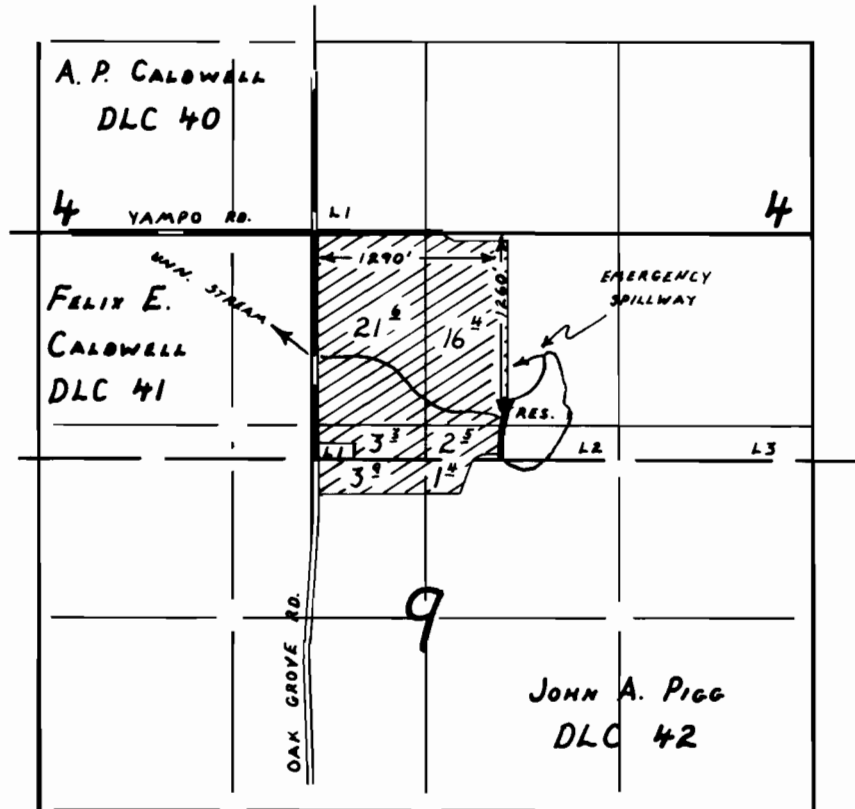

FINAL PROOF SURVEY

UNDER

Application No. R-68934, 68935 Permit No. R-10812, 49868

IN NAME OF

Mark Olson

Surveyed June 22, 1993, by R.W. Klassen