

T.30S.,R.16E.,W.M.

FEB 8 1994

SCALE: 1"=1320'

FINAL PROOF SURVEY



UNDER

APPLICATION NO. 64515 PERMIT NO. 47632

IN NAME OF

OREGON DEPARTMENT OF FISH AND WILDLIFE

SURVEYED OCT 19, 1993, BY R.M. SUTTERFIELD

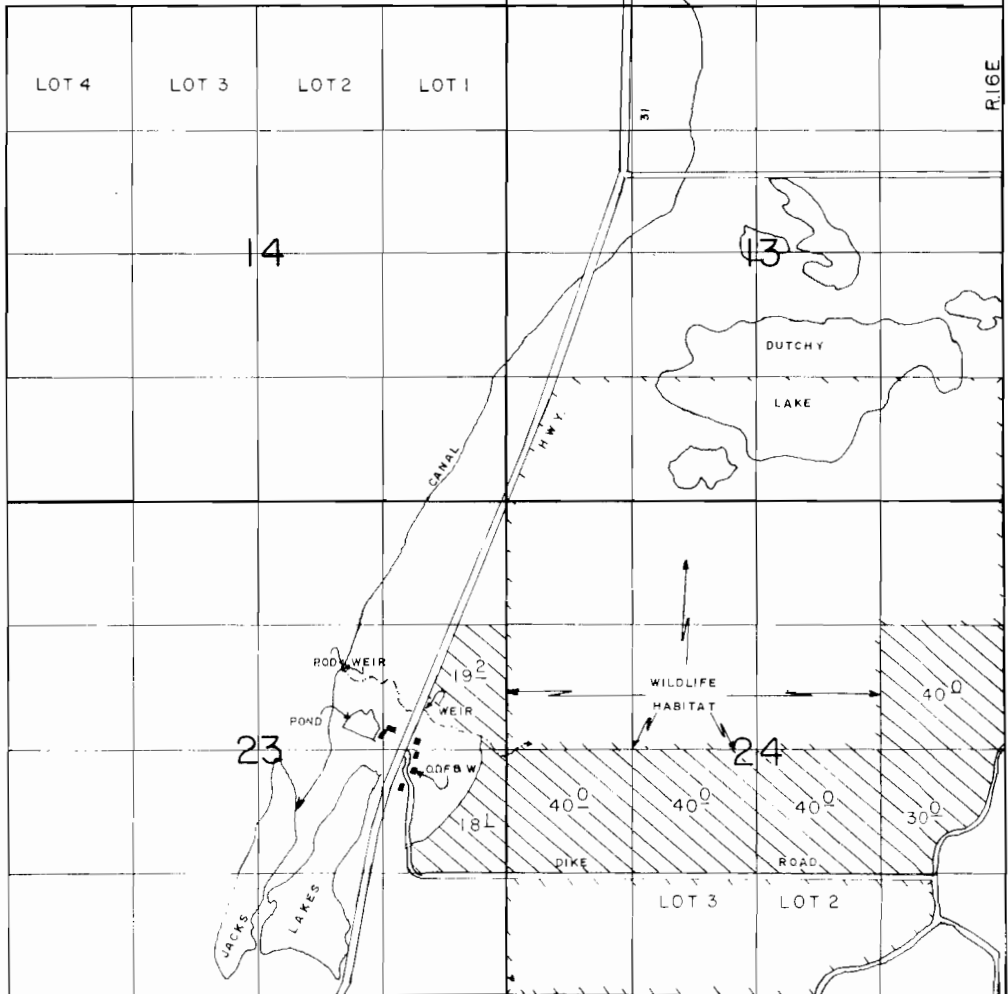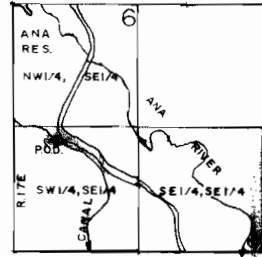

DIV. PT. LOC: 2300' N & 1700' E FROM NW COR. OF SEC 12 IN R 16E
 DIV. PT. LOC: 1150' N & 2170' W FROM SE COR. OF SEC 6 IN R 17E