

T.30S.,R.16E.,W.M.

REF

SCALE: 1"=1320'

# FINAL PROOF SURVEY

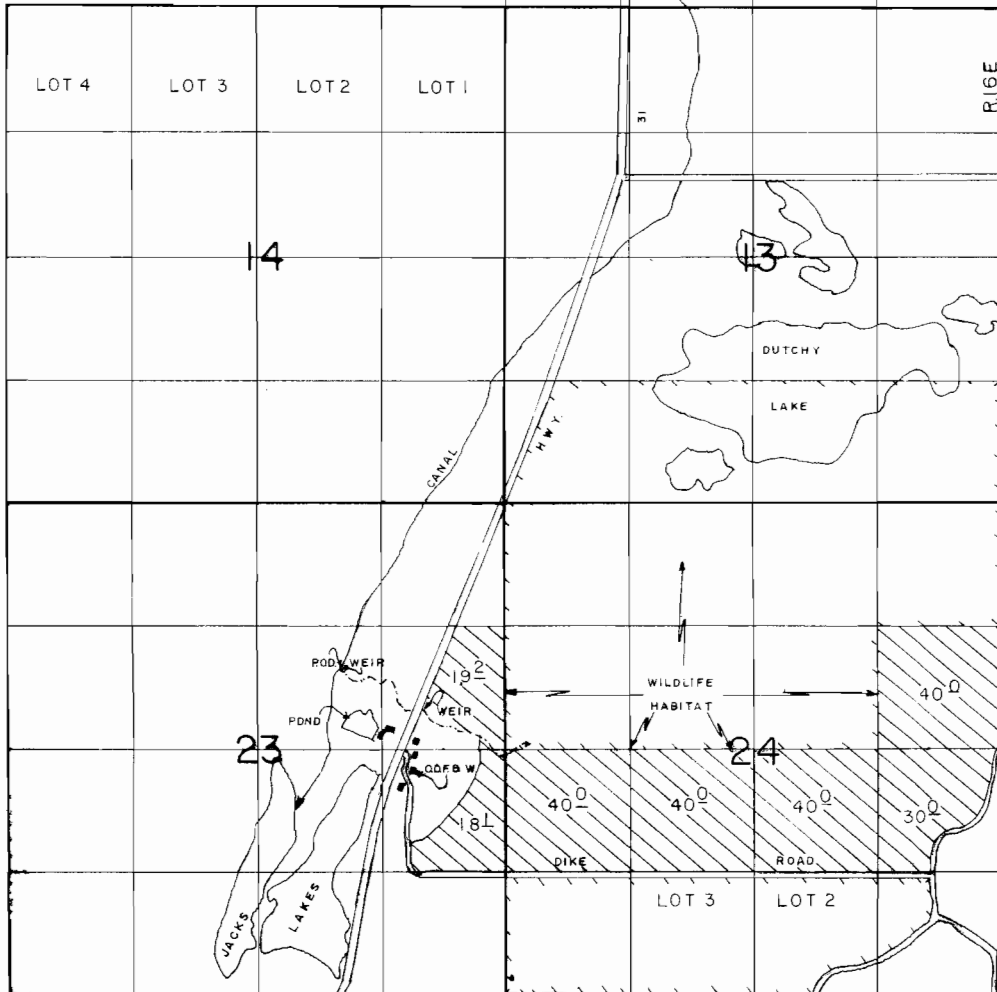
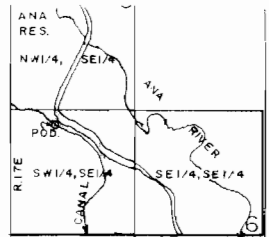
UNDER



APPLICATION NO. 64515 PERMIT NO. 47518  
64519 47632

IN NAME OF

**OREGON DEPARTMENT OF FISH AND WILDLIFE**

SURVEYED OCT 19, 1993, BY R.M. SUTTERFIELD



 DIV. PT. LOC: 2300' N & 1700' E FROM NW COR. OF SEC 12 IN R. 16E.  
 DIV. PT. LOC: 1150' N & 2170' W FROM SE COR. OF SEC 6 IN R. 17E.