


LAKE COUNTY TOWNSHIP 29 SOUTH, RANGE 17 EAST, W.M.

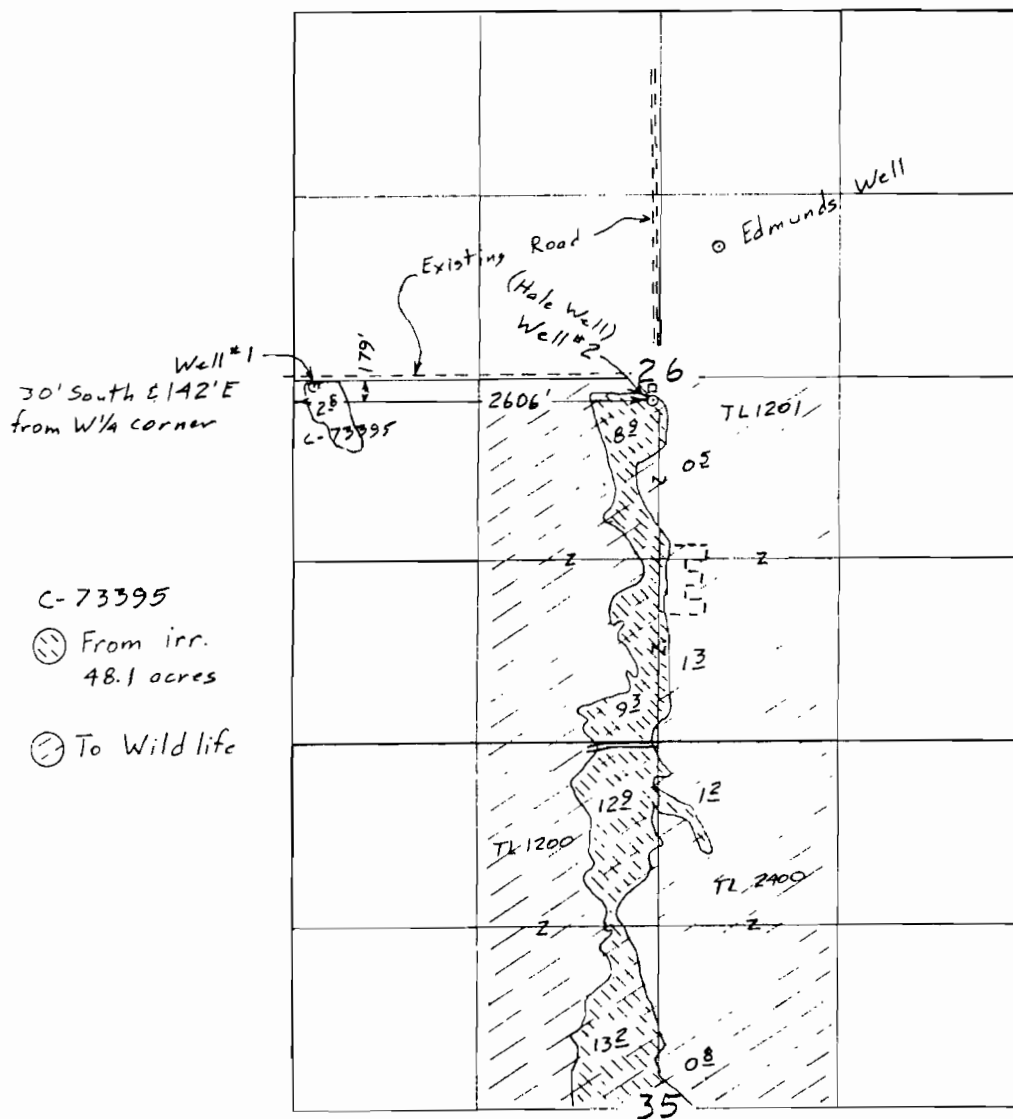

Scale 1" = 1320'
(4" = 1 mile)

RECEIVED

MAY 31 2005


WATER RESOURCES DEPT
SALEM, OREGON

RECEIVED

JUL 13 2005

WATER RESOURCES DEPT
SALEM, OREGON

Application Map
for
DON & CAROL EDMUNDS

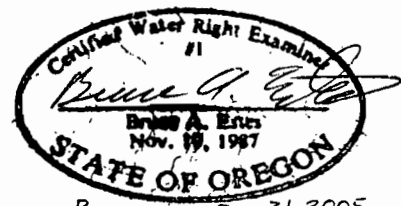

Renewal Dec 31, 2005
Sheet 2 of 2

This map is for the purpose of
locating a water right only
and has no intent to provide
legal dimensions or the location
of property lines.

T-9970

ESTES SURVEYS, LLC

P.O. Box 17519
Salem, OR 97305-7519
(503) 565-7593
80382 Arnold Rd
Bend, OR 97702
(541) 382-7391