

LAKE COUNTY TOWNSHIP 29 SOUTH, RANGE 17 EAST, W.M.

RECEIVED

MAY 31 2005

WATER RESOURCES DEPT
SALEM, OREGON

Remain in Place

⊖ G-10729


⊖ G-11952

⊖ From G-11952
(Hale Well)

⊖ To

Proposed Well #3

50' N & 440' E from
SW Cor Sec 26

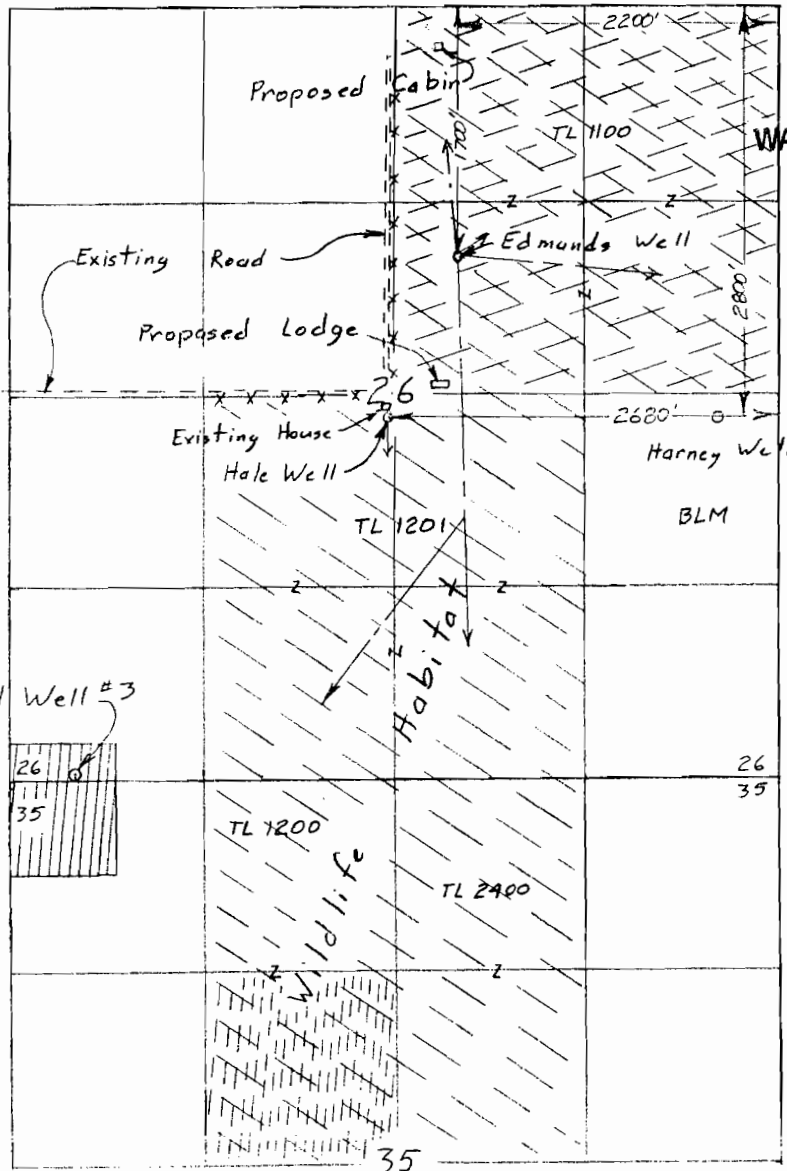


Scale 1" = 1320'
(4" = 1 mile)

RECEIVED

JUL 13 2005

WATER RESOURCES DEPT
SALEM, OREGON

Application Map
for
DON & CAROL EDMUNDS

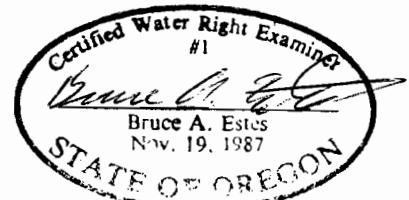

Renewal Dec 31, 2005
Sheet 1 of 2


ESTES SURVEYS, LLC

PO Box 17519 60382 Arnold Rd
Salem, OR 97305-7519 Bend, OR 97702
(503) 585-7593 (541) 382-7391

This map is for the purpose of
locating a water right only
and has no intent to provide
legal dimensions or the location
of property lines.

T-9970

LAKE COUNTY
TOWNSHIP 29 SOUTH, RANGE 17 EAST, W.M.

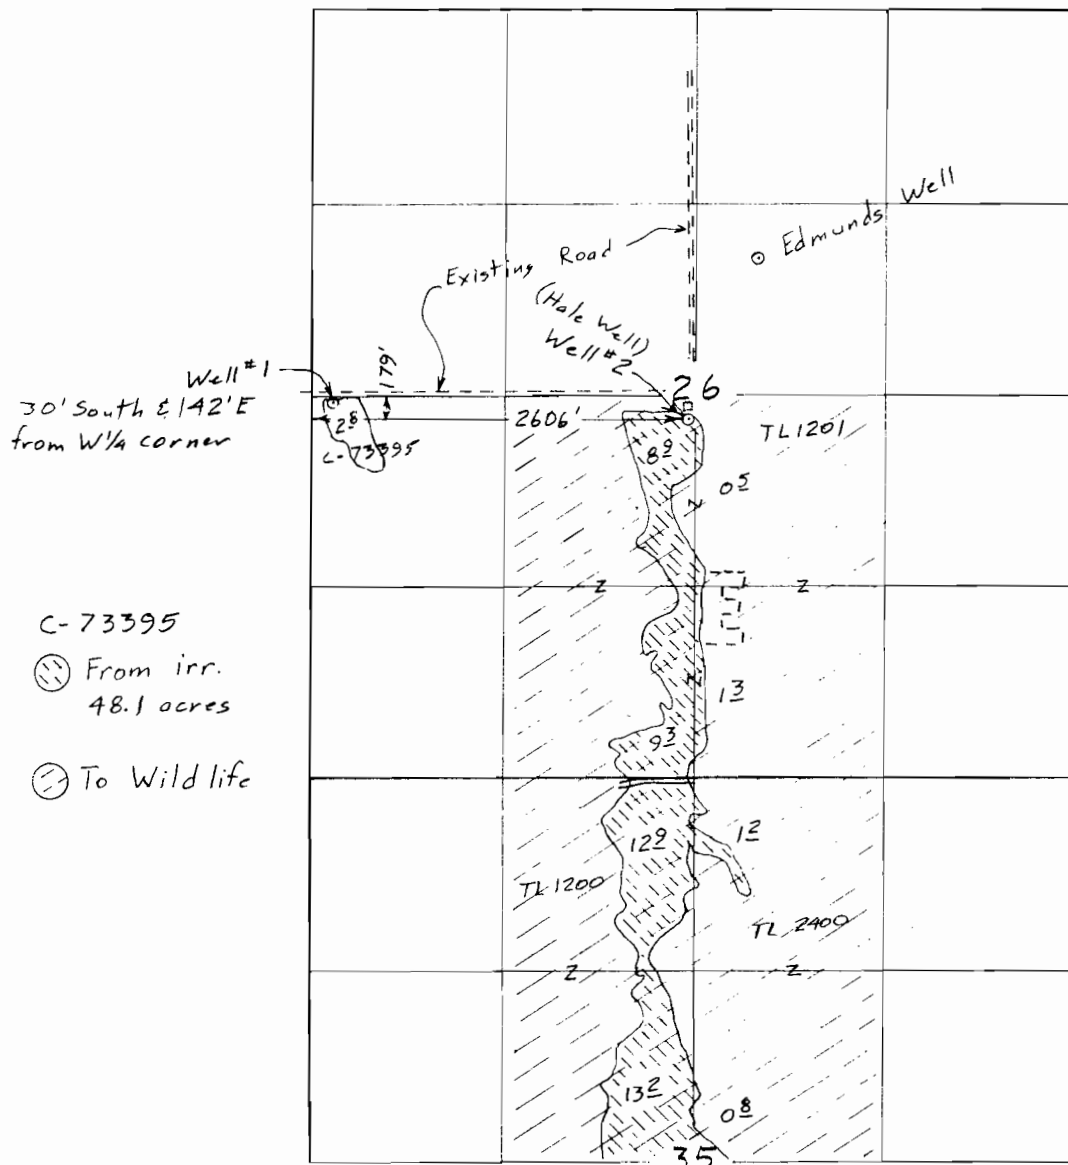

Scale 1" = 1320'
(4" = 1 mile)

C-73395

☉ From irr.
48.1 acres

☉ To Wild life

RECEIVED

MAY 31 2005

WATER RESOURCES DEPT
SALEM, OREGON


RECEIVED

JUL 13 2005

WATER RESOURCES DEPT
SALEM, OREGON

Application Map
for

DON & CAROL EDMUNDS

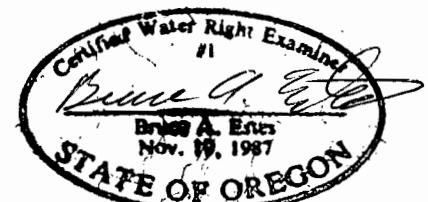

Renewal Dec 31, 2005
Sheet 2 of 2

T-9970

This map is for the purpose of
locating a water right only
and has no intent to provide
legal dimensions or the location
of property lines.

ESTES SURVEYS, LLC

PO Box 17519
Salem, OR 97305-7519
(503) 585-7593

60382 Arnold Rd
Bend, OR 97702
(541) 382-7391