


Permit: S 34233
Volume: 6B
Strm: A RESERVOIR
Trib: W FK WILLIAMS CR
Priority: 3/14/69

Permit: S 34233
Volume: 6B
Strm: W FK WILLIAMS CR
Trib: WILLIAMS CR
Priority: 3/14/69

T.39S. R.5W. W.

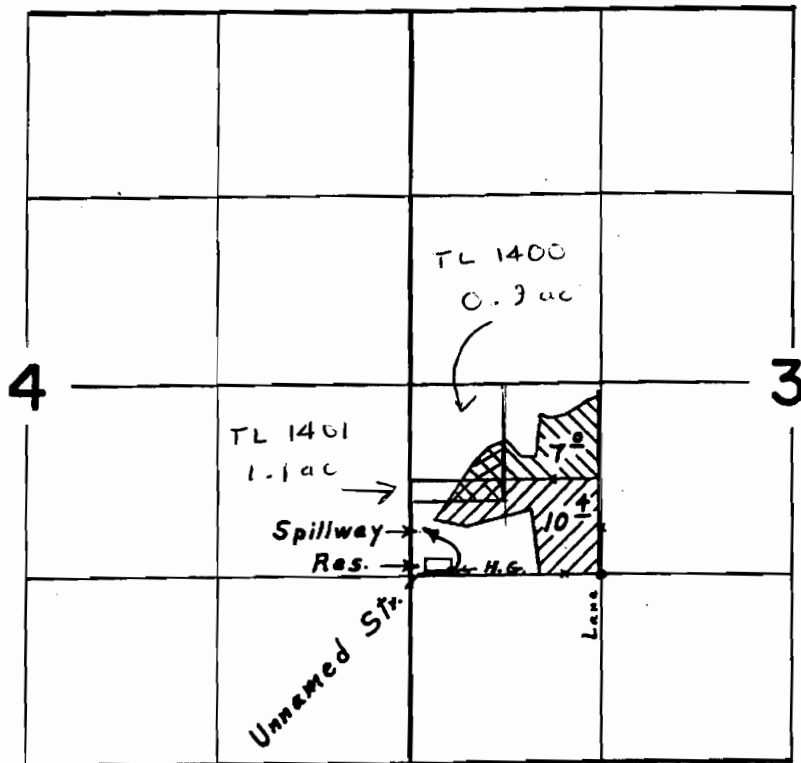

Div. Pt. 10c. 10' N. & 1030' W. from S.E. Cor. N.W. 1/4 S.W. 1/4 Sec. 3

Primary 
Supplemental 

Partial Cancellation

~~FINAL PROOF SURVEY~~
UNDER

R-45050 R-5450
Application No. 45851 Permit No. 34233
IN NAME OF

MARGERY W. OVERACKER & THE ESTATE OF HORACE OVERACKER

Surveyed May 23, 1975, by L. E. Gould

Partial Cancellation

RECEIVED

DEC 21 2006

WATER RESOURCES DEPT
SALEM, OREGON