


T-4806

T. 8 S., R. 21 E., W.M.

TRANSFER APPLICATION MAP FOR
HOMER & TWILA SCHELL

T-4806

S.C.V. 35 P. 376

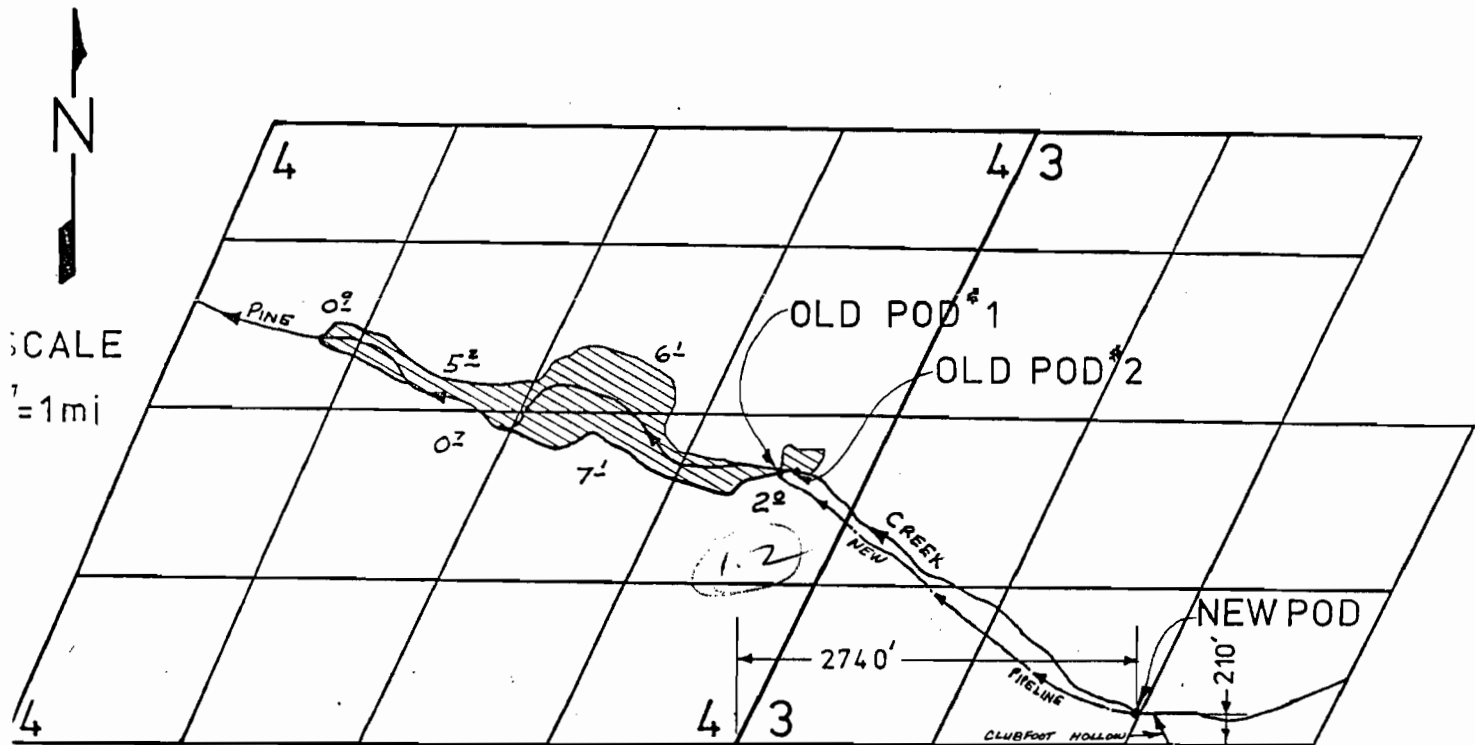

APPROVED

*Add train fisher
Canby OR.
40 or 30*

RECEIVED

JUN 30 1981

WATER RESOURCES DEPT
SALEM, OREGON