


T4N R27E W.M.

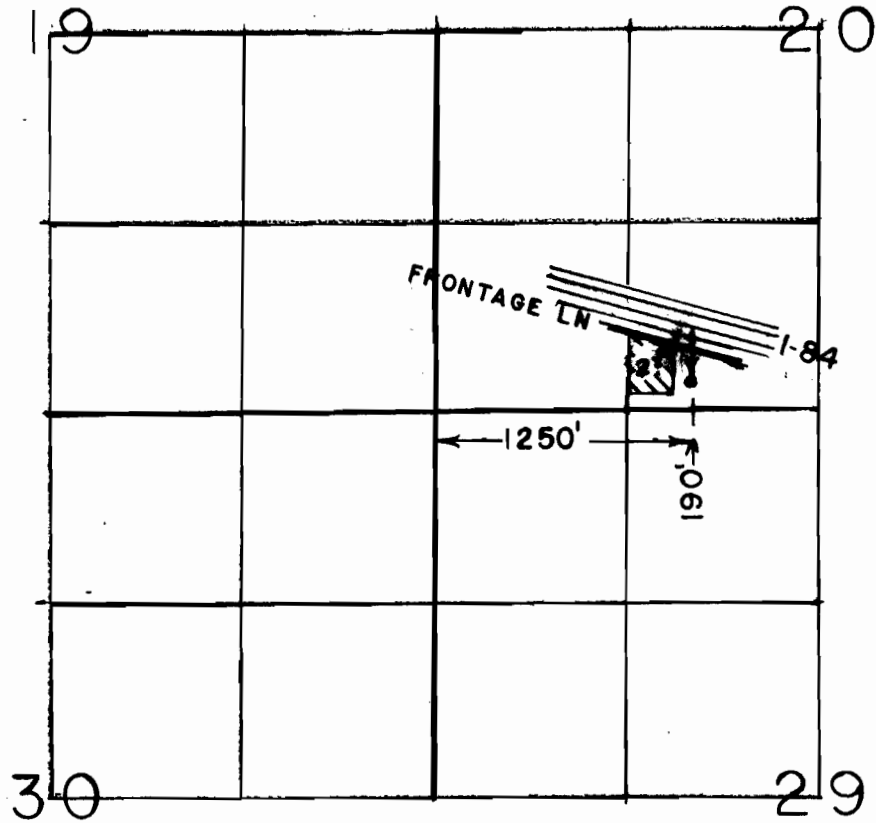

FINAL PROOF SURVEY
UNDER

TRANSFER 5737

Application No. Permit No.

IN NAME OF

..... THOMAS & PAMELA MANN

Surveyed AUG 1995, by J. MILLER