


T. 40 S., R. 12 E., W.M.

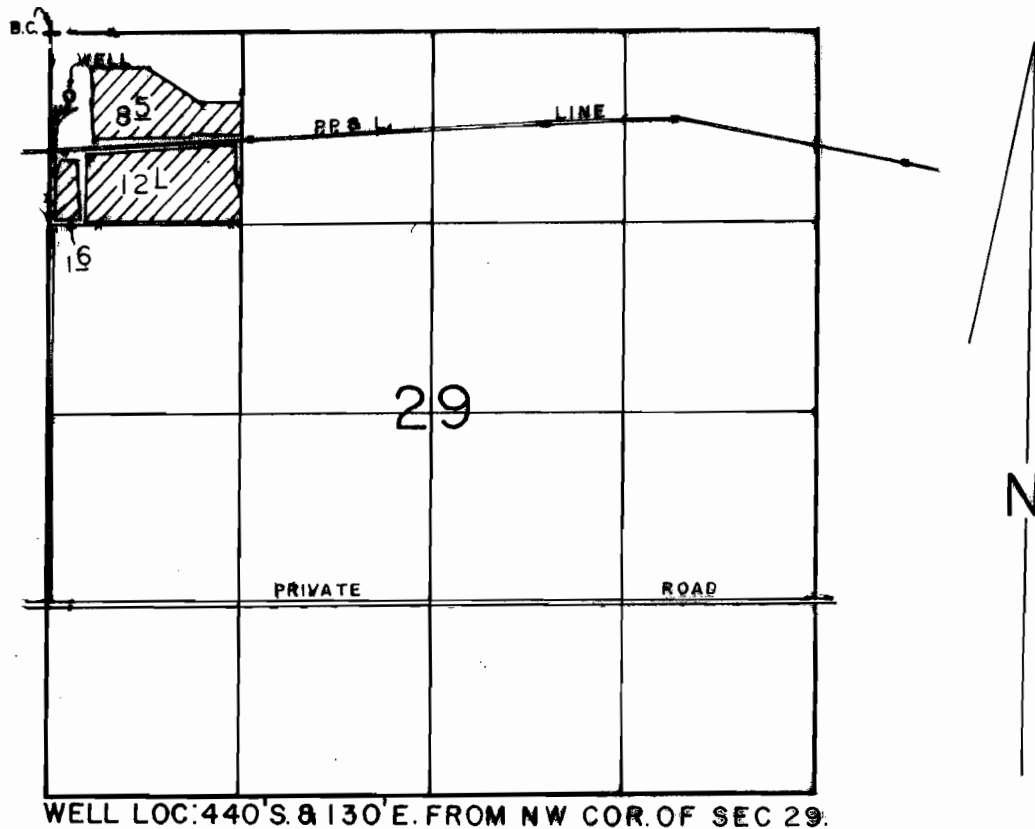

WELL LOC: 440' S. & 130' E. FROM NW COR. OF SEC 29.

SCALE: 1" = 1320'

FINAL PROOF SURVEY UNDER

Application No. G-11215 Permit No. G-10405
IN NAME OF

FRUIT GROWERS SUPPLY COMPANY

Surveyed MAY 26, 1992, by B.W. BISHOP