


T.34S., R.7E., W.M.

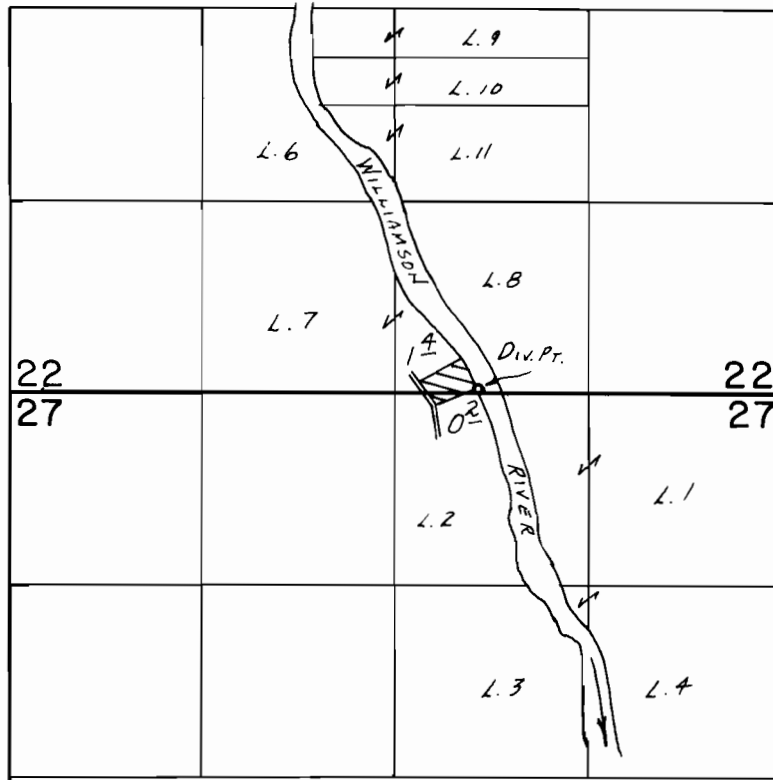

Div. Pt. Loc.: 30' N. & 570' E. FROM S. 1/4 COR. SEC. 22

SCALE: 1" = 1320'

### FINAL PROOF SURVEY UNDER

Application No. 54130 Permit No. 40521.....  
IN NAME OF

..RICHARD A. & PETRA S. CONTO..

Surveyed June 27, 1991., by B.W. BISHOP.....