


T. 34 S., R. 6 E., W.M.

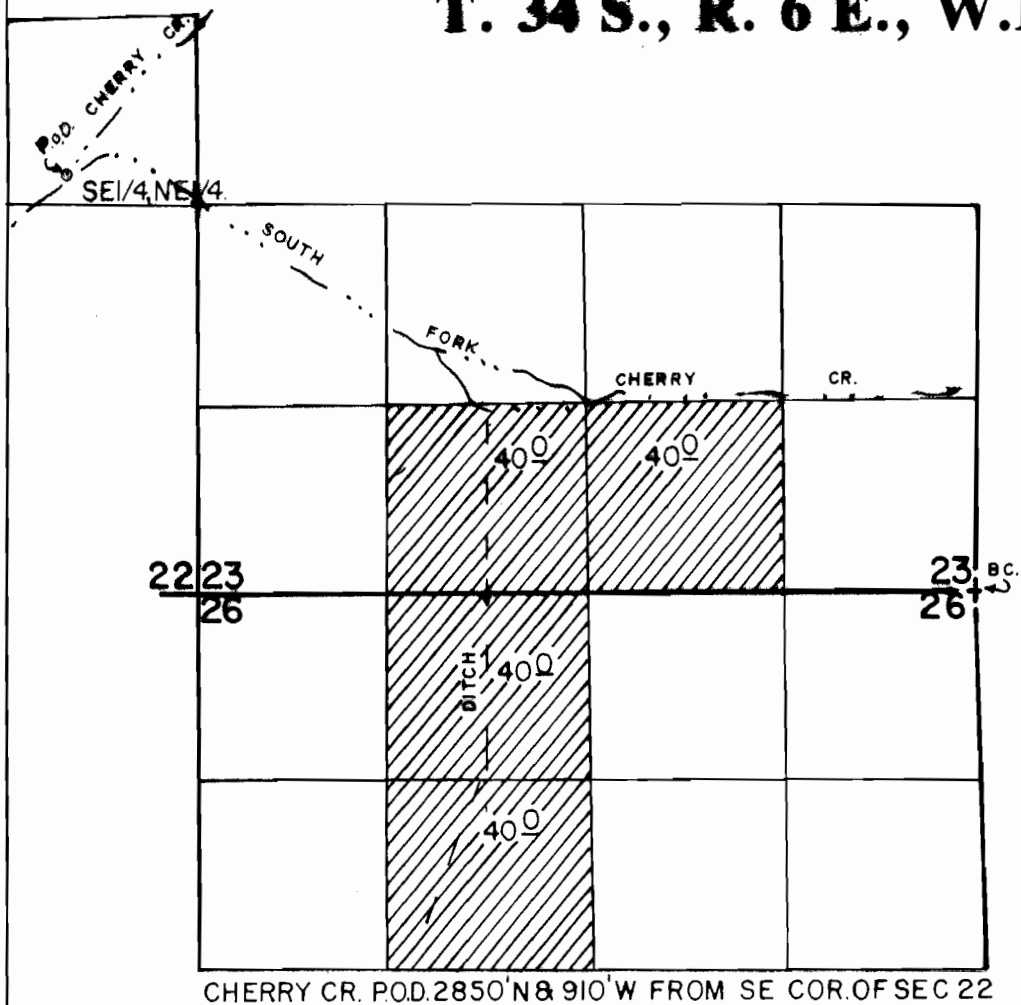

SCALE: 1" = 1320'

FINAL PROOF SURVEY

UNDER

Application No. 48312 Permit No. 36277
IN NAME OF

ANNE C. BROWN

Surveyed JUNE 20, 1994, by R.M. SUTTERFIELD