


T. 36 S., R. 12 E., W.M.

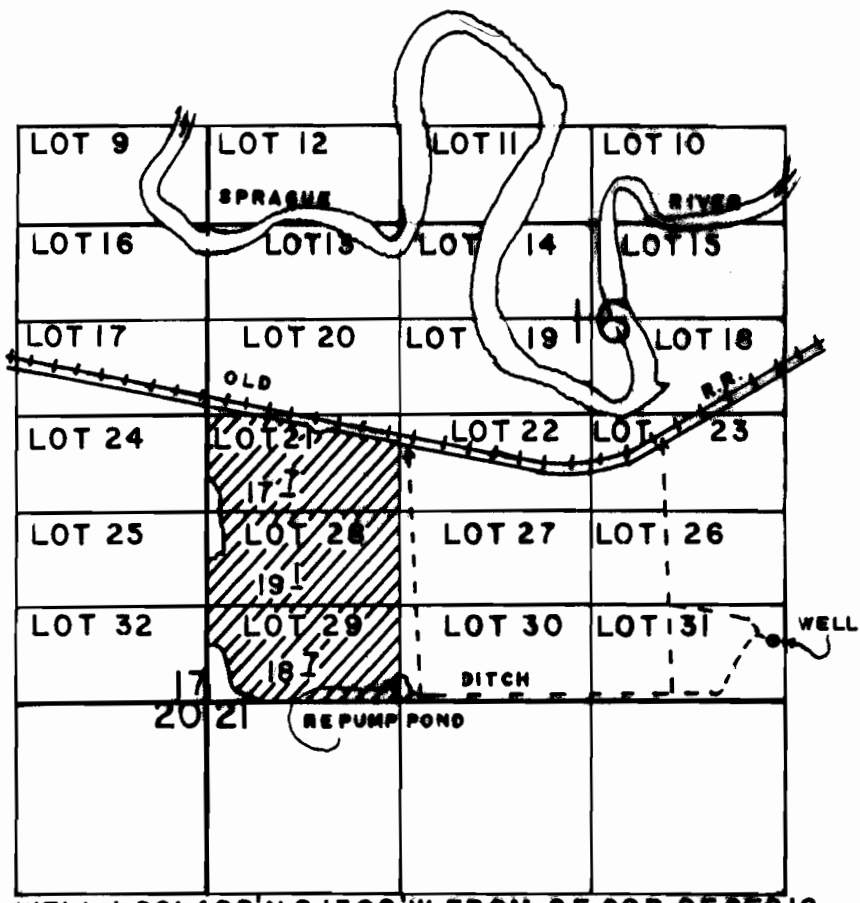

WELL LOC: 400' N & 1390' W FROM SE COR. OF SEC. 16.
350

SCALE: 1" = 1320'

FINAL PROOF SURVEY

UNDER

Application No. G-6939 Permit No. G-6662
IN NAME OF

RICHARD L. & BARBARA A. SETHER

Surveyed MAY 18, 1994 by R.M. SUTTERFIELD