


T. 35 S., R. 9 E., W.M.

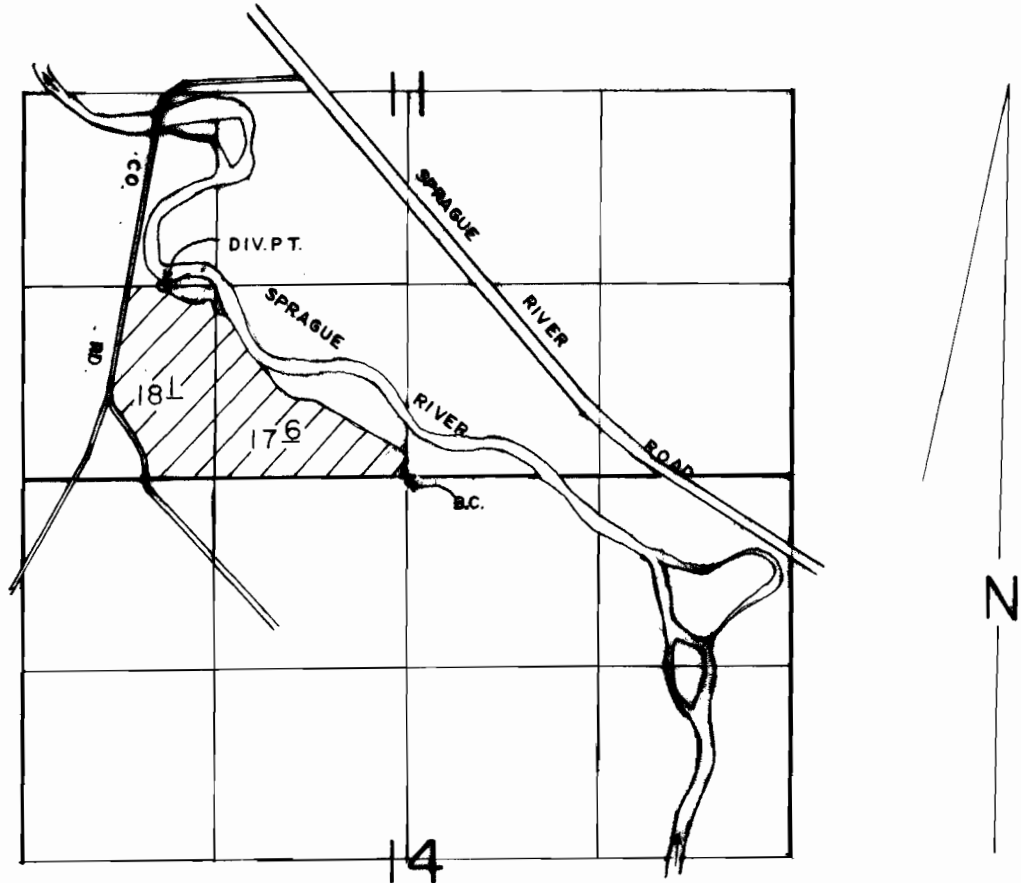

DIV. PT. LOC: 1320' N & 1670' W FROM S1/4 COR. OF SEC 11.

SCALE: 1" = 1320'

FINAL PROOF SURVEY

UNDER

Application No. 55457 Permit No. 41523
IN NAME OF

JERRY R. AND IRENE F. BRANDON

Surveyed JUNE 4, 1992, by B.W. BISHOP