


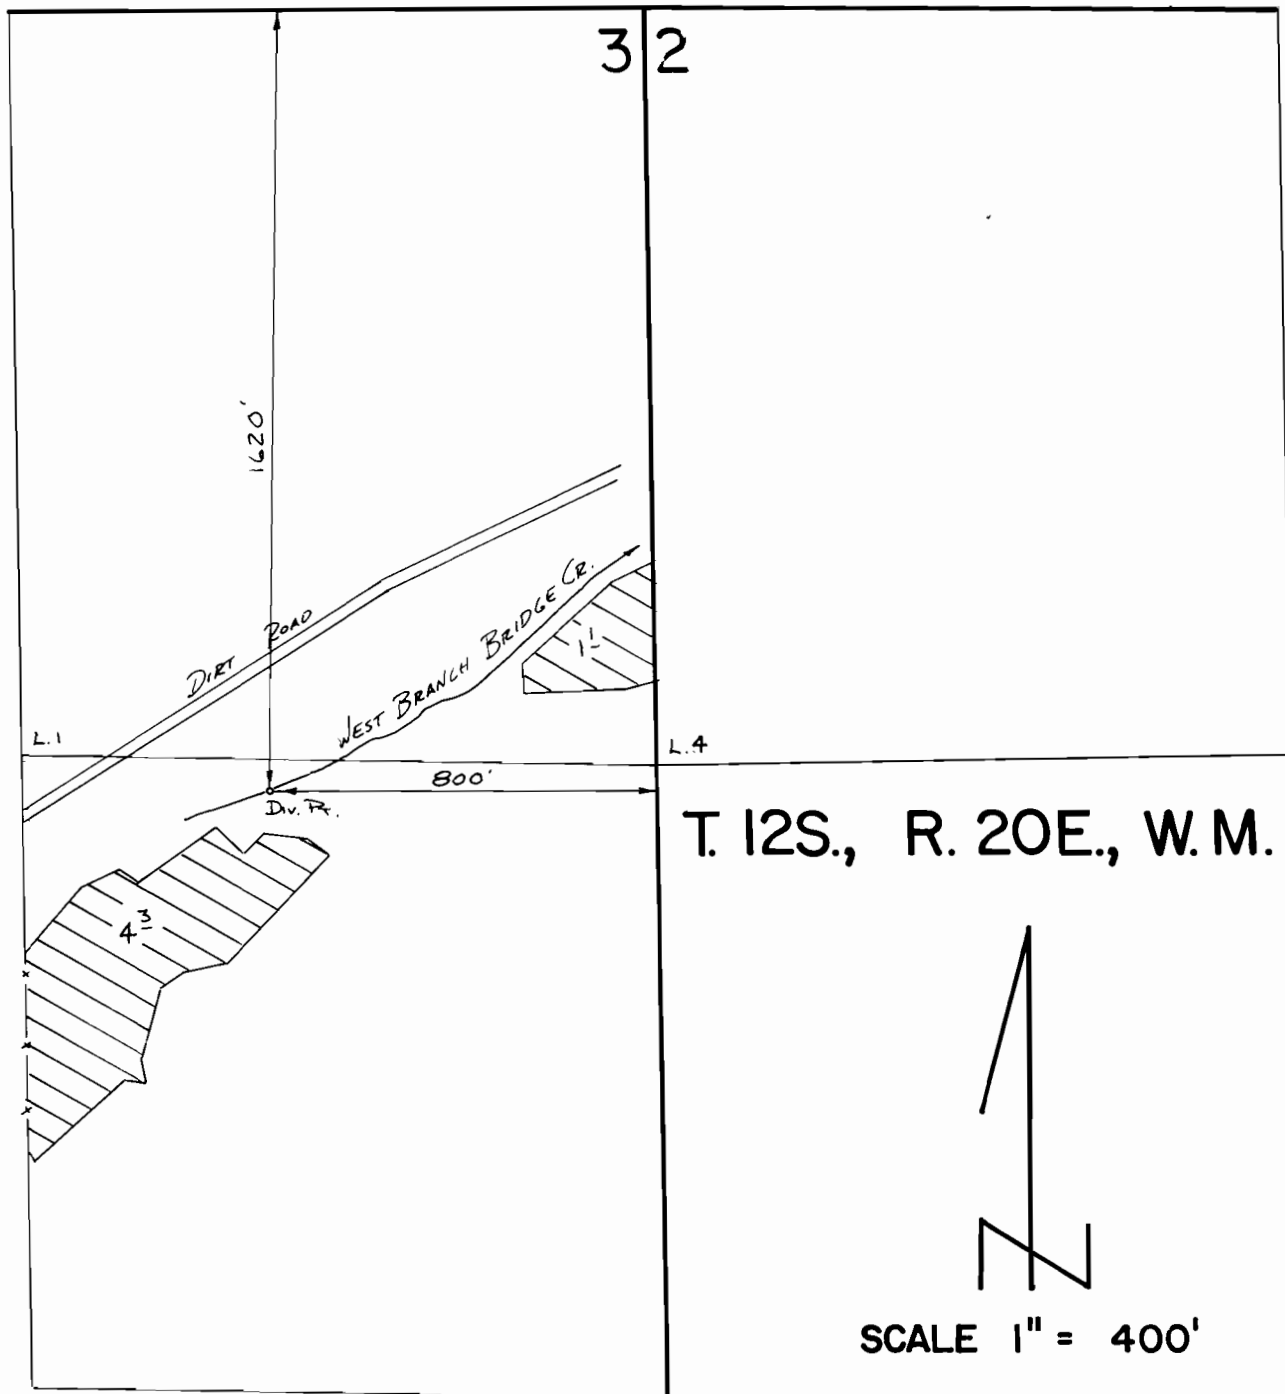

FINAL PROOF SURVEY UNDER

T-3018

Application No. **52186** Permit No. **37529**
IN NAME OF

DANIEL LEO HOWE

Surveyed **5-11** 19**87**, by **V.L. Church**