
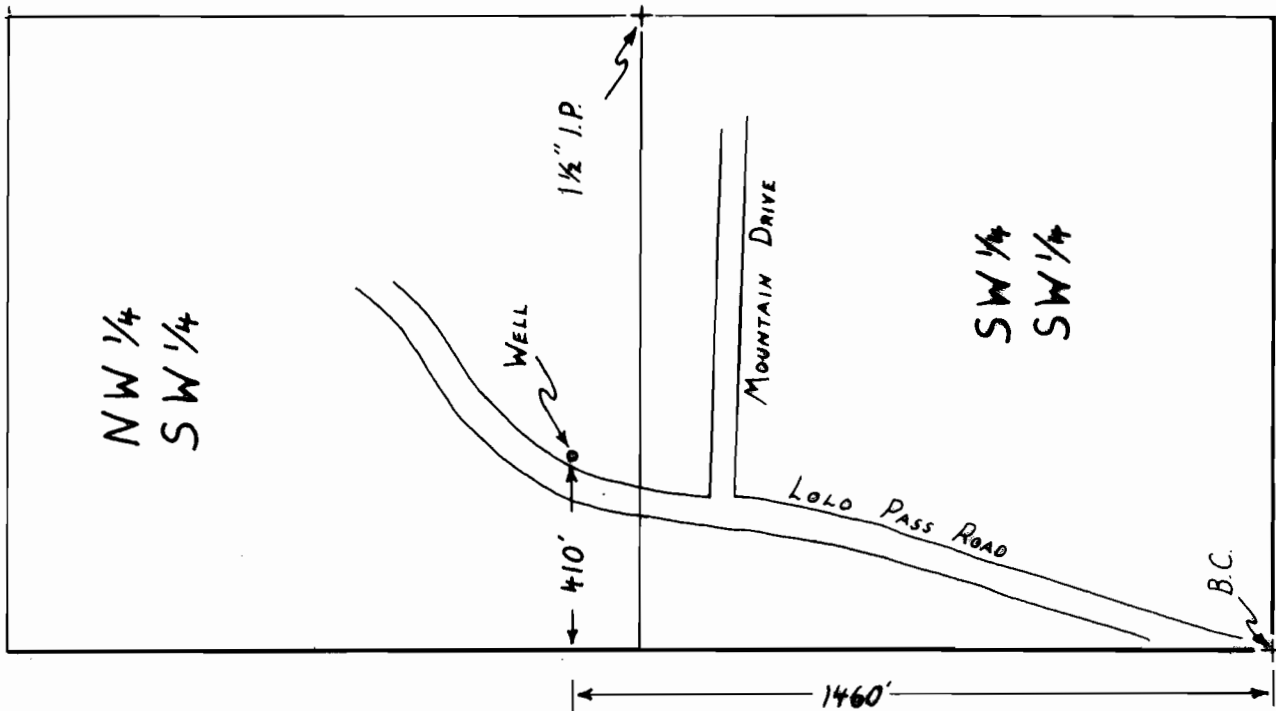


T. 2 S., R. 7 E., W.M.

SECTION 34

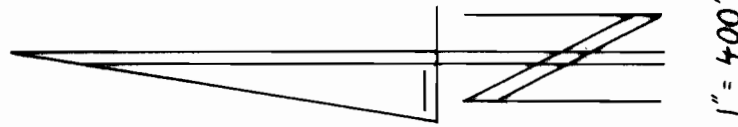

FINAL PROOF SURVEY

UNDER

Application No. G-5913 Permit No. G-6344
IN NAME OF

River Rapids Water Cooperative

Surveyed May 12, 1994, by R.W. Klassen