


TOWNSHIP 9 SOUTH, RANGE 20 EAST, W.M

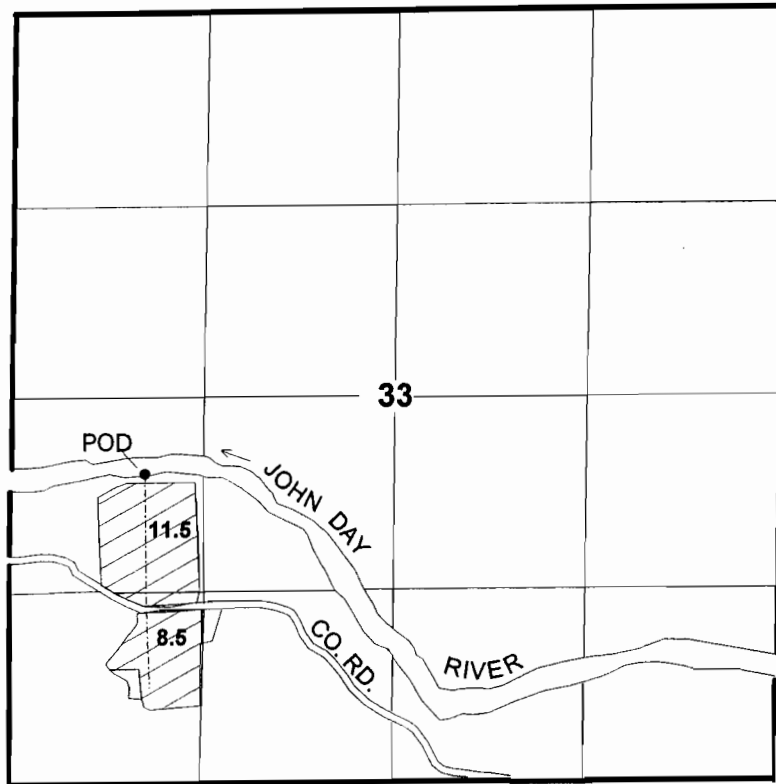

1" = 1320'

POD - 2140 FEET NORTH AND 920 FEET EAST FROM THE SOUTHWEST CORNER OF SECTION 33.

FINAL PROOF SURVEY

UNDER

Application No. 58643 Permit No. 44215

IN THE NAME OF

A. JOSEPH AND O. VIRGINIA PETTY

Surveyed: May 15, 2001 by: June Miller

RECEIVED

DEC 23 2002

WATER RESOURCES DEPT.
SALEM, OREGON