


T 385, R 17E

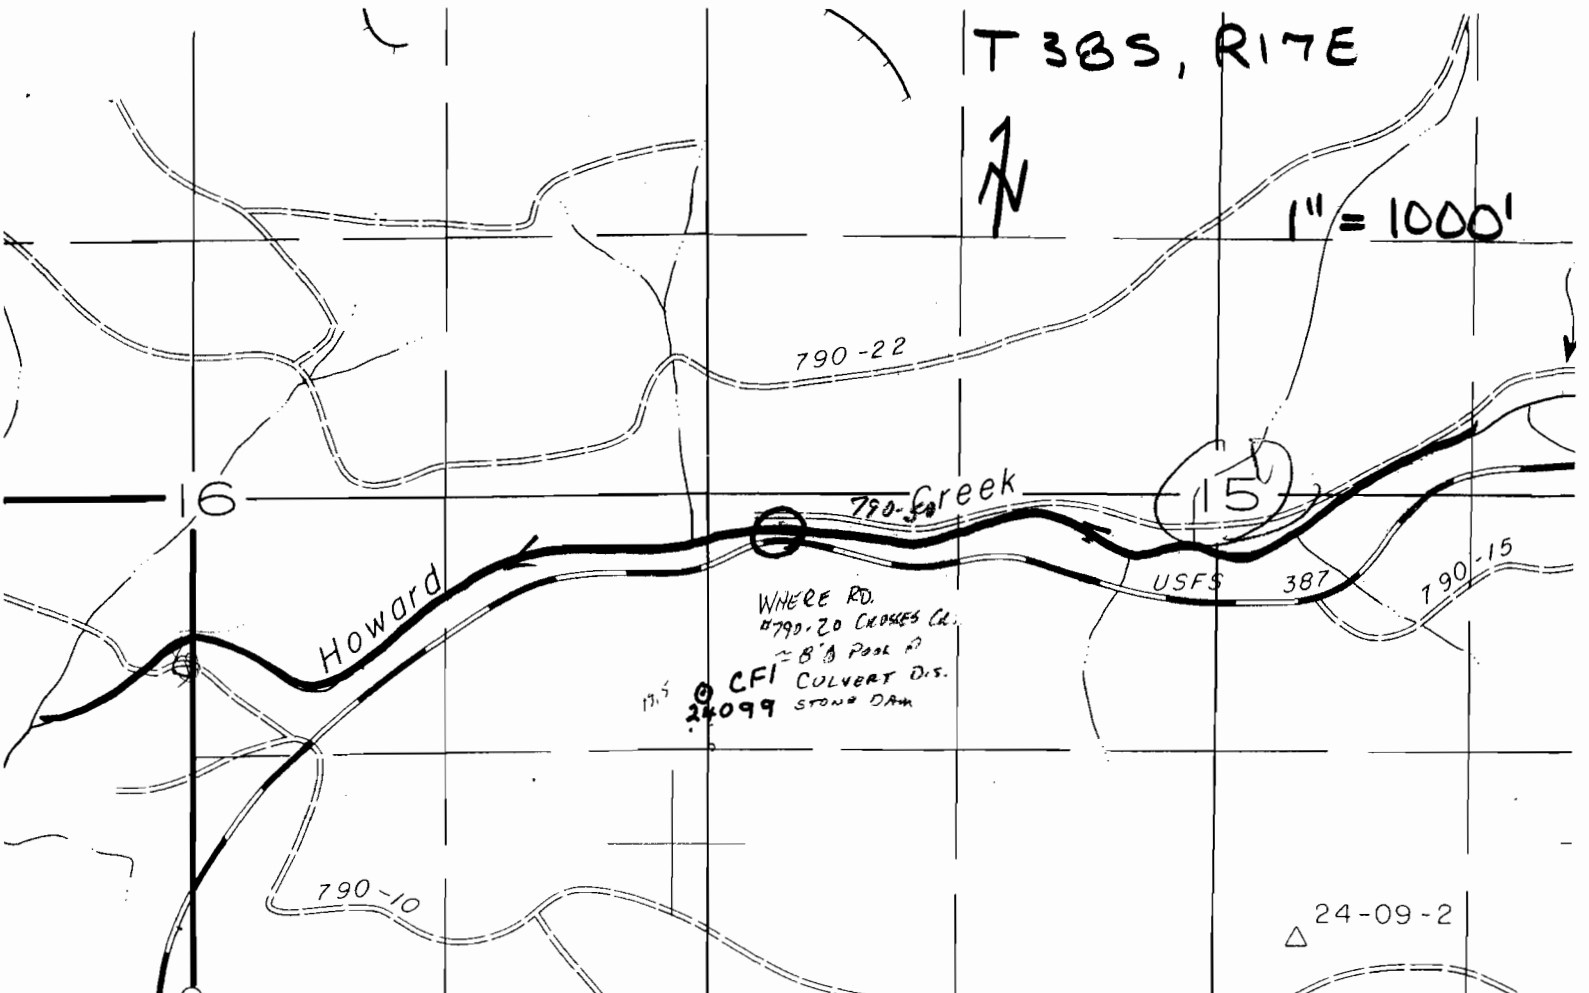

1" = 1000'



Application No. 58914
Permit No. 44474

RECEIVED

OCT - 2 1979

WATER RESOURCES DEPT
SALEM, OREGON

RECEIVED

JUL 16 1979

WATER RESOURCES DEPT
SALEM, OREGON

DATE