


T.40S.,R.17E.,W.M.

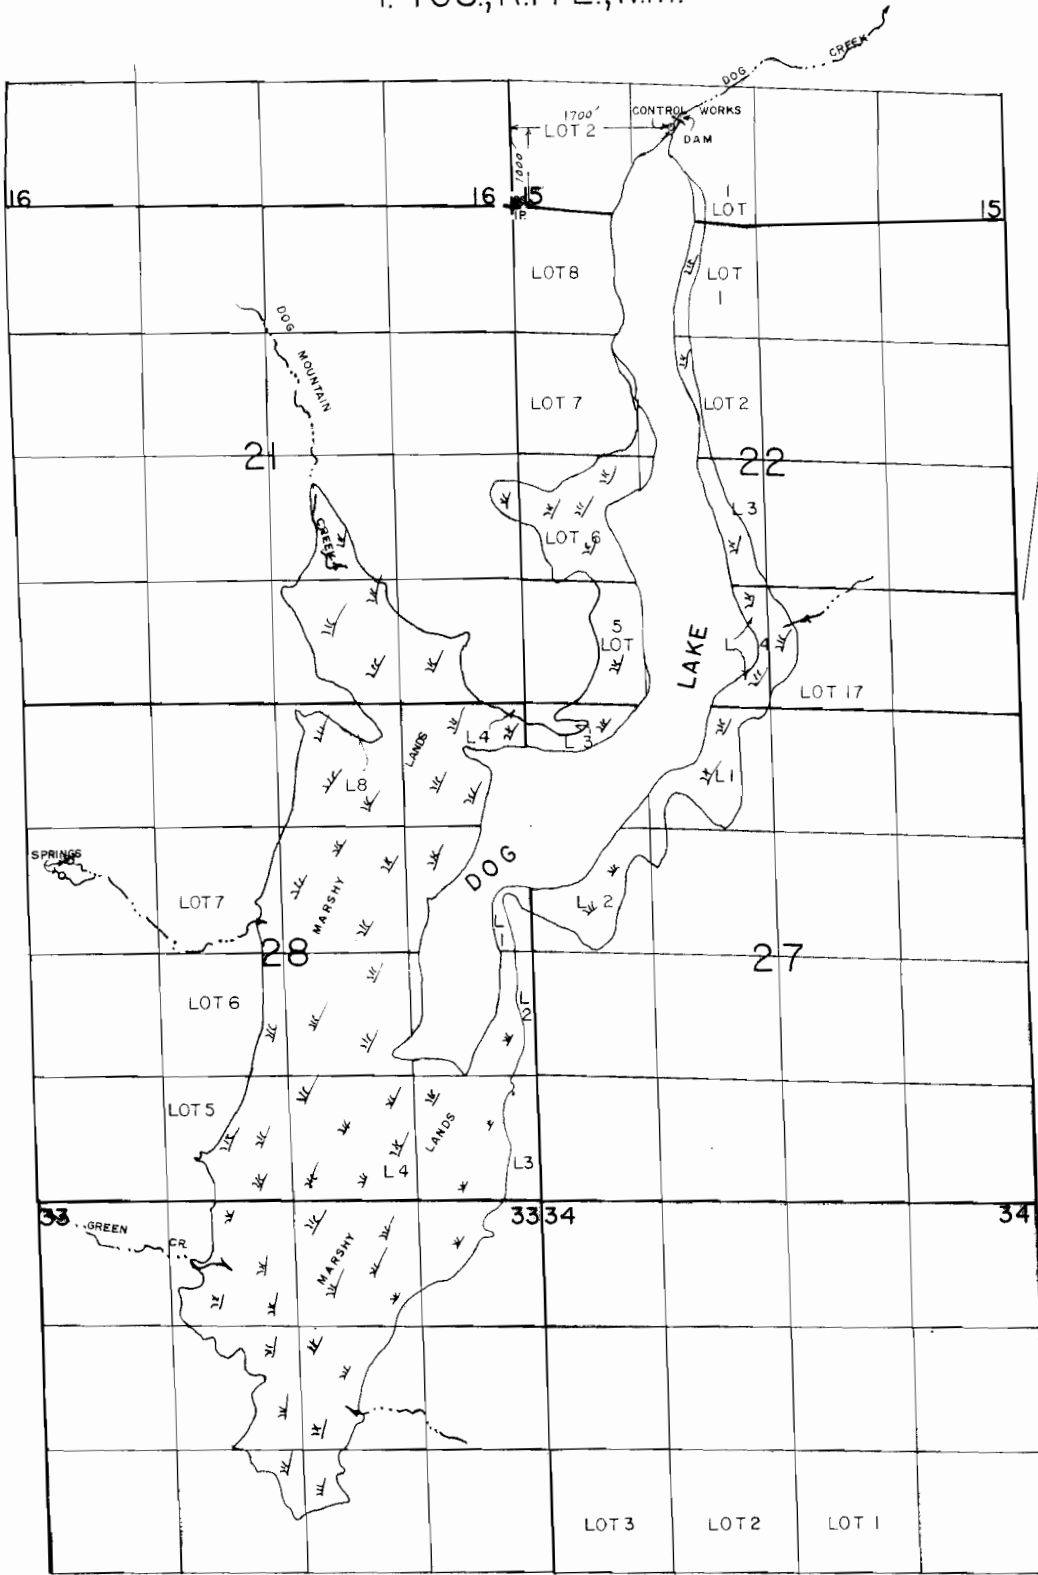

SCALE: 1"=1320'

FINAL PROOF SURVEY

UNDER

Application No. 61813 Permit No. 49677
R-61747 R-10626

IN NAME OF

UNITED STATES, FREMONT NAT. FOREST

SURVEYED AUG 16, 1990, by B.W. BISHOP