
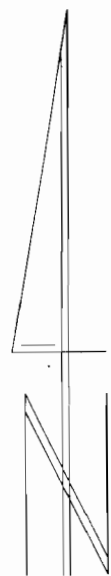


T 3 & 4 N, R 1 W, W. M.

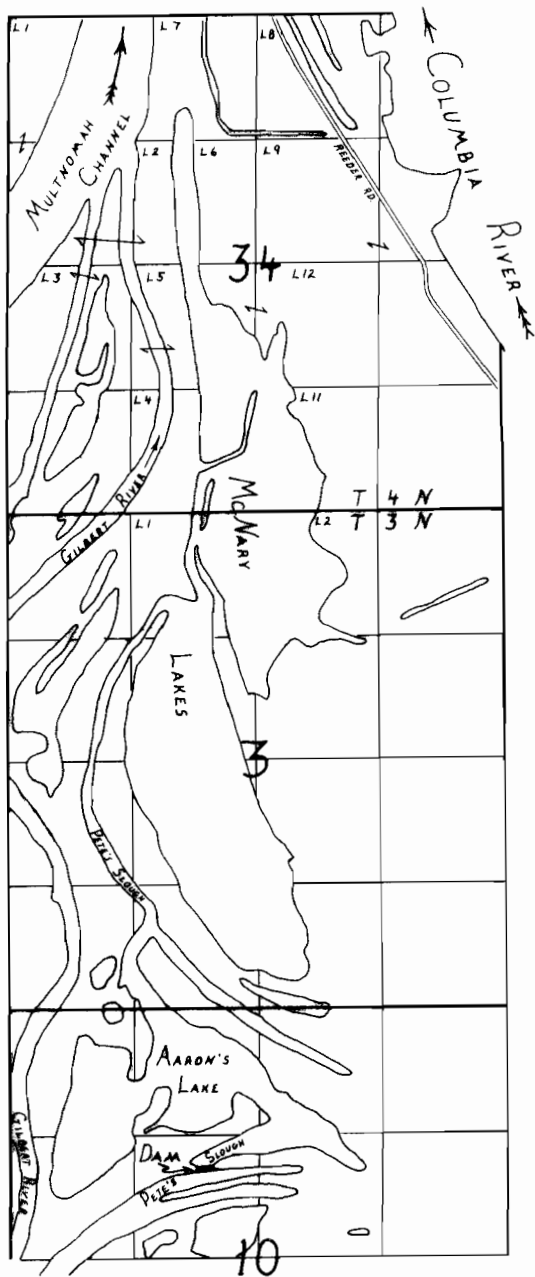

1" = 1320'

FINAL PROOF SURVEY
UNDER

56343 43072
APPLICATION R-57438 PERMIT R-7341

IN NAME OF

OREGON DEPARTMENT OF FISH & WILDLIFE

SURVEYED JULY 16, 1992, BY R.W. KLASSEN