
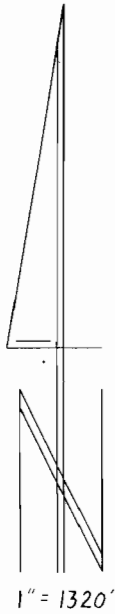


T 3 & 4 N, R 1 W, W.M.

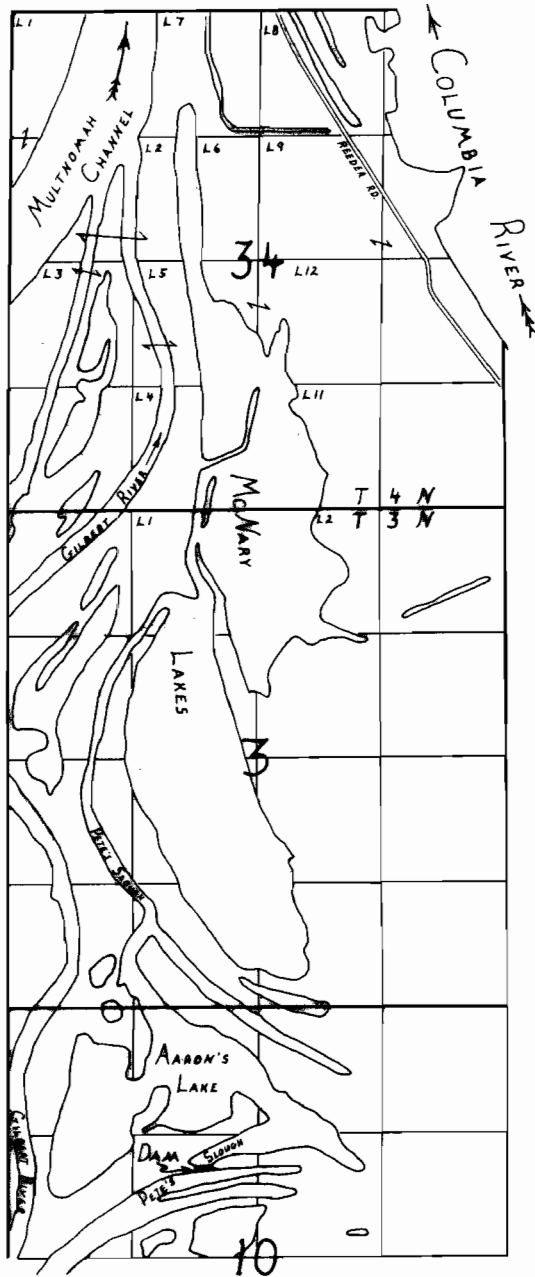

1" = 1320'

FINAL PROOF SURVEY  
UNDER  
56343 43072  
APPLICATION R-57438 PERMIT R-7341  
IN NAME OF  
OREGON DEPARTMENT OF FISH & WILDLIFE  
SURVEYED JULY 16, 1992, BY R.W. KLASSEN