


**Township 7 and 8 South, Range 25 East, W.M.**

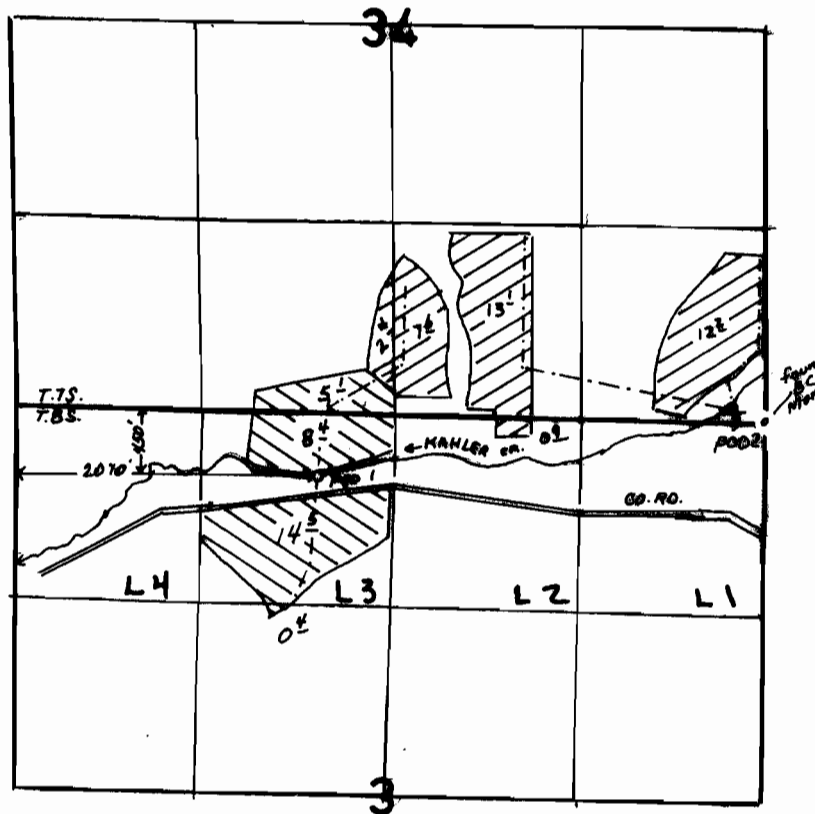

POD 2 - 100' N. & 250' W. FROM THE SE COR. SEC. 34.

1" = 1320'



PERMIT 40523



PERMIT 49701

**FINAL PROOF SURVEY  
UNDER**

Application No. 54132.. Permit No. 40523.....  
IN NAME OF

JAMES & MARY DOHERTY.....

Surveyed 6-7..... 2000, by J. MILLER.....

10-31-06 JWG  
41069-172-6LH 4-19-01 JM