


T. 4 S., R. 23 & 24 E., W.M.

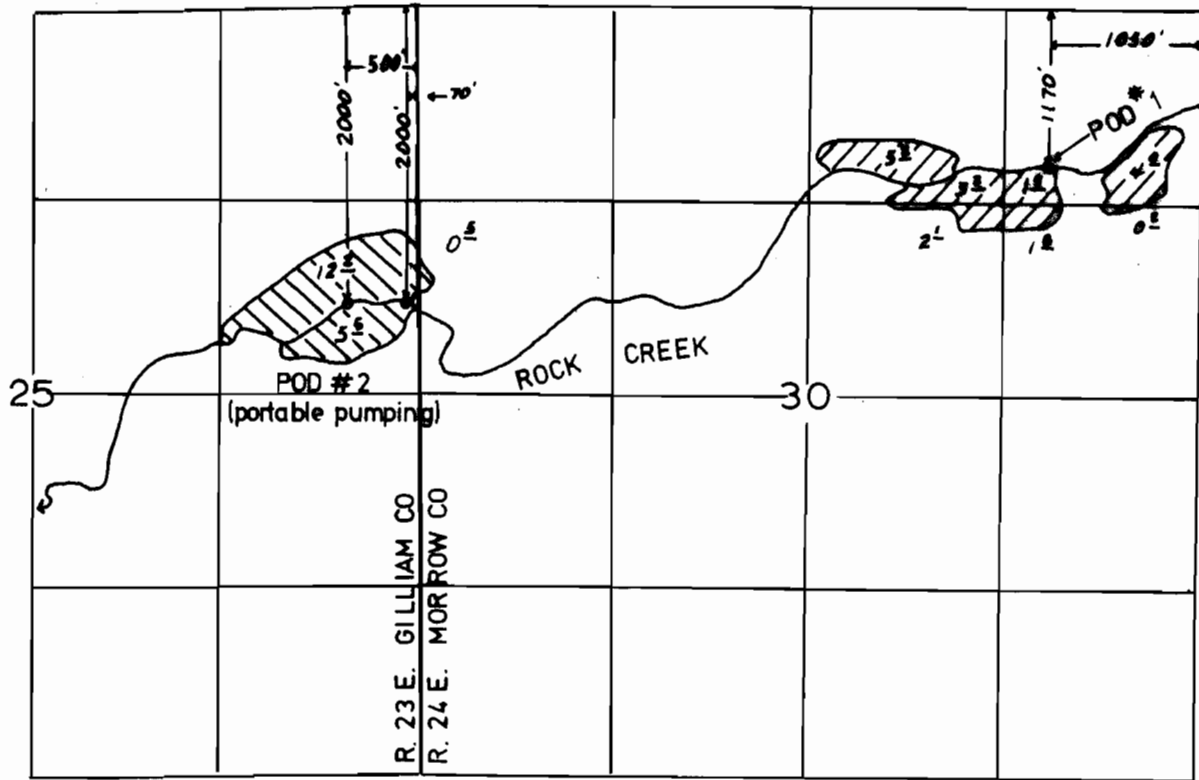

-  IRR. FROM POD # 1
-  IRR. FROM POD # 2
(portable pumping)

1" = 1320'



FINAL PROOF SURVEY UNDER

Application No. 54684 Permit No. 41028
IN NAME OF

CARSON BROTHERS RANCH

Surveyed 9-9, 1993, by J. MILLER