


T. 39 S., R. 8 E., W.M.

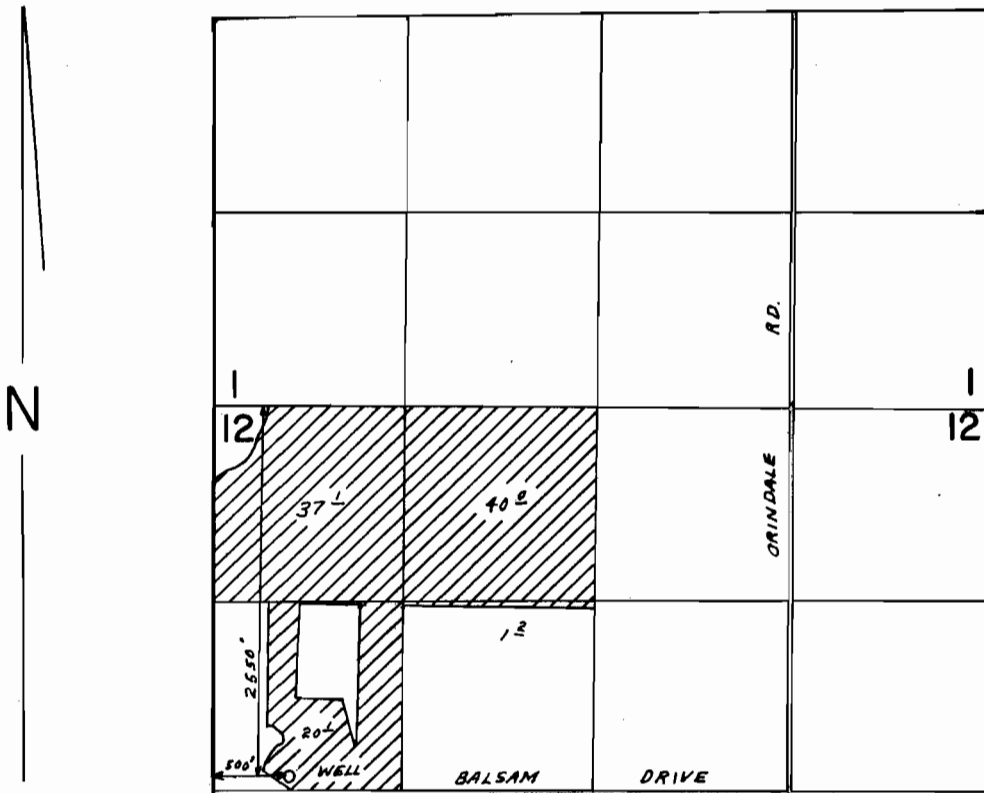

SCALE: 1" = 1320'

FINAL PROOF SURVEY UNDER

Application No. G-11021 Permit No. G-10186
IN NAME OF

DONALD E. & NANCY I. KUCERA

Surveyed JUL. 20 1988, by B. BISHOP

1-27-89

J.S.C.