


T.36S.,R.12E.,W.M.

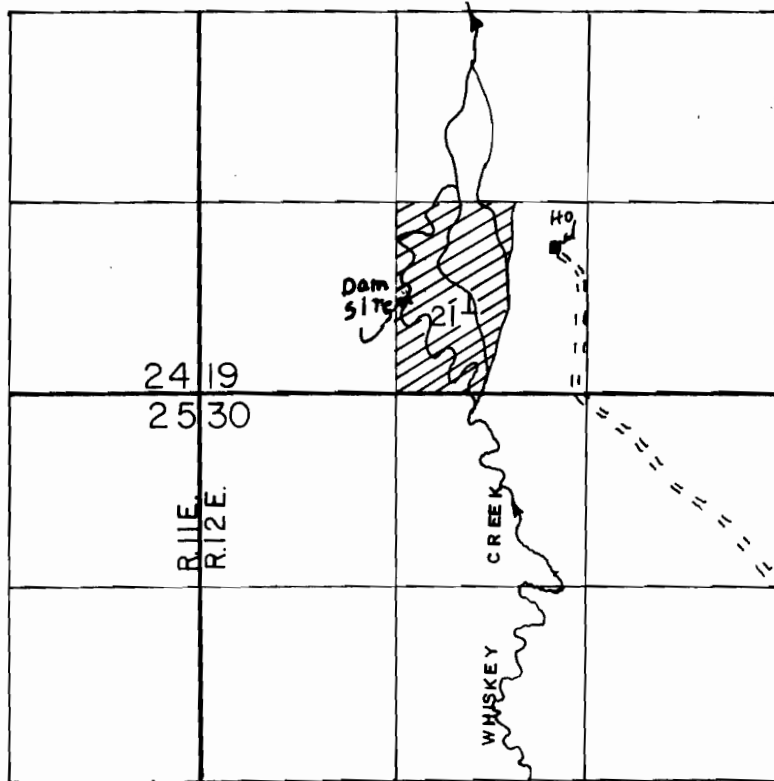

POD. 605' N & 1390' E FROM SW COR. OF SEC 19.

SCALE: 1" = 1320'

FINAL PROOF SURVEY
UNDER

Application No. 51667... Permit No. 38957....
IN NAME OF

.....DELL GEORGE SMITH, JR.....

Surveyed APRIL 30 1996, by R.M. SUTTERFIELD