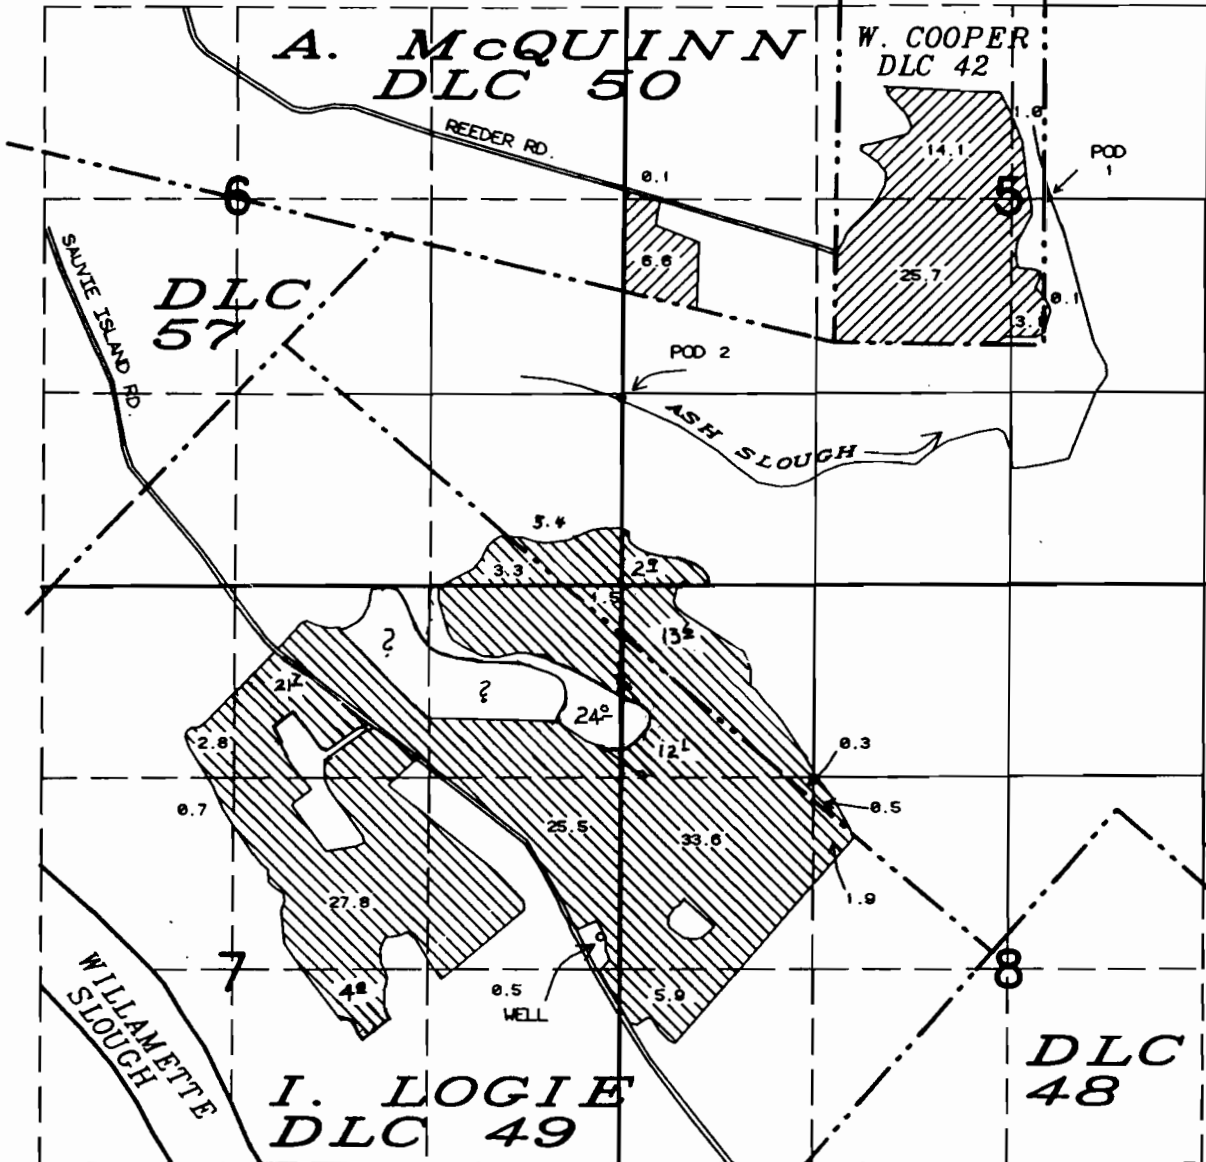

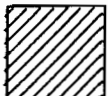


T. 2 N., R. 1 W., WM



WELL LOCATED 2400 FT S AND 140 FT W FROM THE NE CORNER SECTION 7
 POD 1 LOCATED 1000 FT N AND 20 FT E FROM THE SE CORNER DLC 42
 POD 2 LOCATED 350 FT S AND 1450 FT W FROM THE SE CORNER DLC 50

 PERMIT G-9537
 PERMIT 46704

FINAL PROOF SURVEY
 UNDER

Application No.: G-9741 63221 Permit No.: G-9537 46704

IN THE NAME OF
 PACIFIC COAST NURSERY

Surveyed: MAY 14, 1987

By: T. M. WARREN revised DEK '96
 RWK