


T.18S., R.9E., W.M.

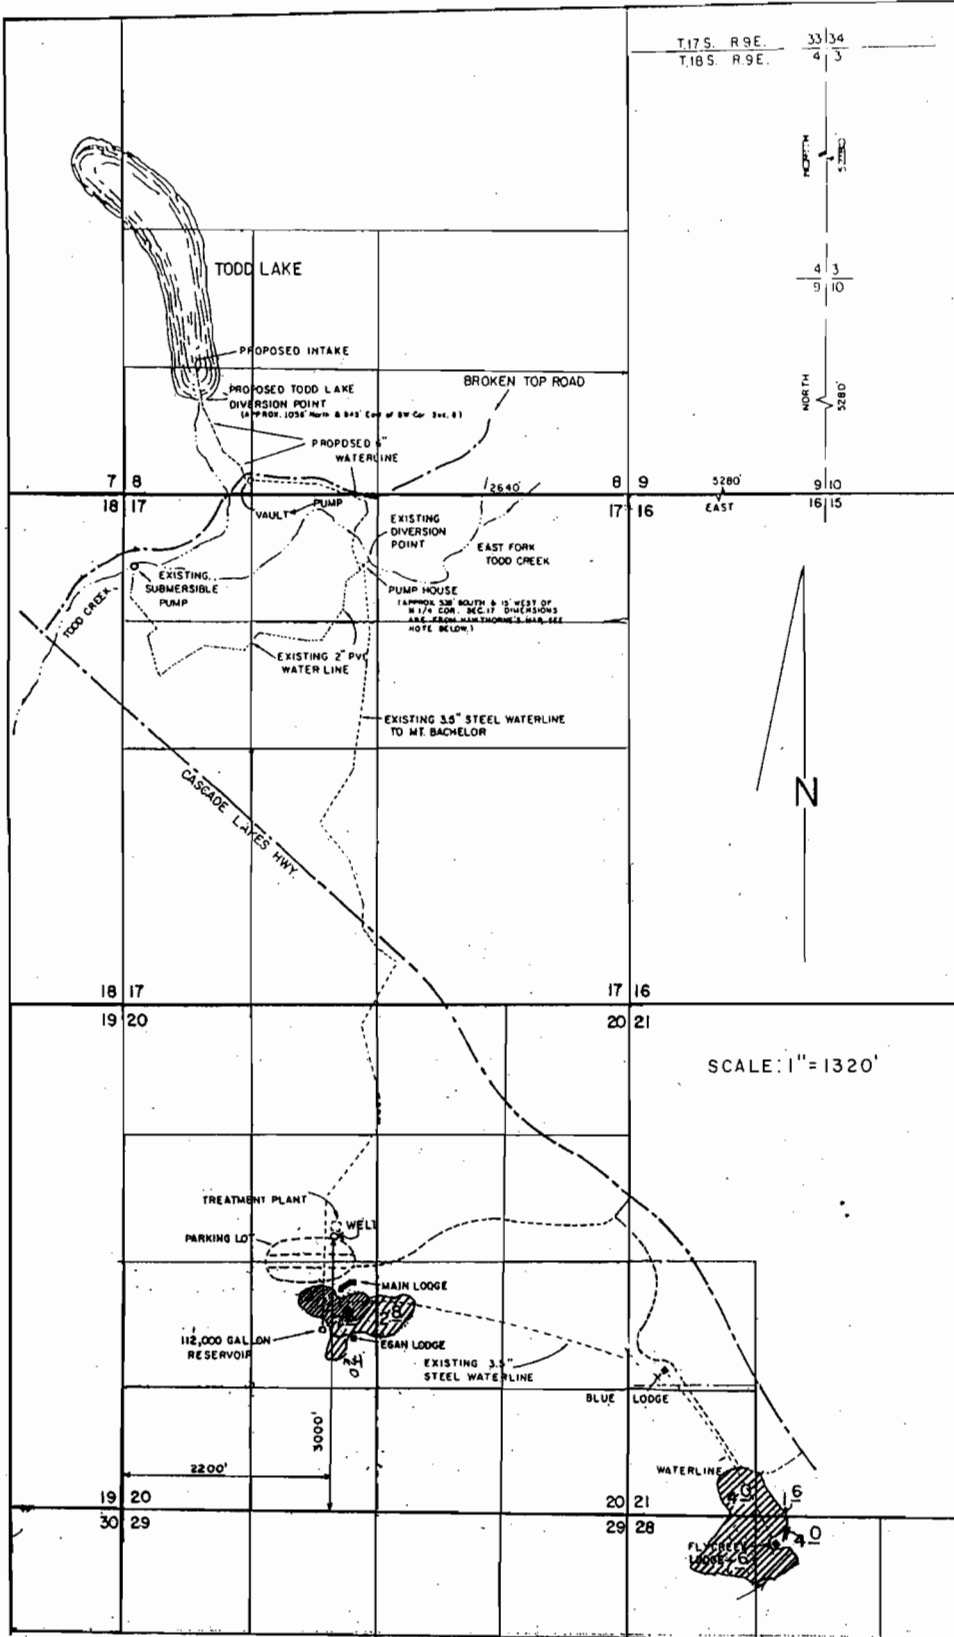

FINAL PROOF SURVEY

UNDER

APPLICATION NO. G-11341 PERMIT NO. G-10562

IN NAME OF

MT. BACHELOR, INC.

SURVEYED SEPT.30,1993, BY R.M.SUTTERFIELD

RECEIVED

FEB - 8 1994

WATER RESOURCES DEPT.
SALEM, OREGON