

THIS MAP WAS PREPARED FOR
ASSESSMENT PURPOSES ONLY

1700

SEE MAP 2 IE 28

SE 1/4 SEC 28 T2S. R1E. W.M.
CLACKAMAS COUNTY

D. L. C.
HENRY SAFFARANS
JAMES ATHEY
NO. 57
NO. 59

2 IE 28D

1" = 200'

SEE MAP 2 IE 28DA

500

205

EAST
PORTLAND
FREEWAY

21200

BORLAND RD.

TUALATIN MEADOWS

RR.F-5
3-04

TUALATIN RIVER

JOHNSON RD.

21600

SEE MAP 2 IE 28C

SEE MAP 2 IE 33

SEE MAP 2 IE 33AB

SEE MAP 2 IE 28DD

FINAL PROOF SURVEY

UNDER



Application No. G11644 Permit No. G 10753

IN NAME OF



Surveyed June 13, 1991, by *P. L. Klassen*

1" = 200'

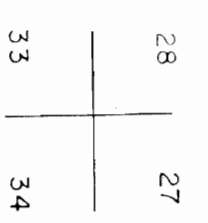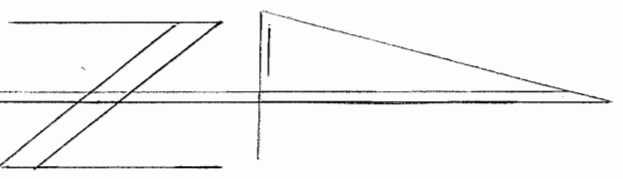

22000

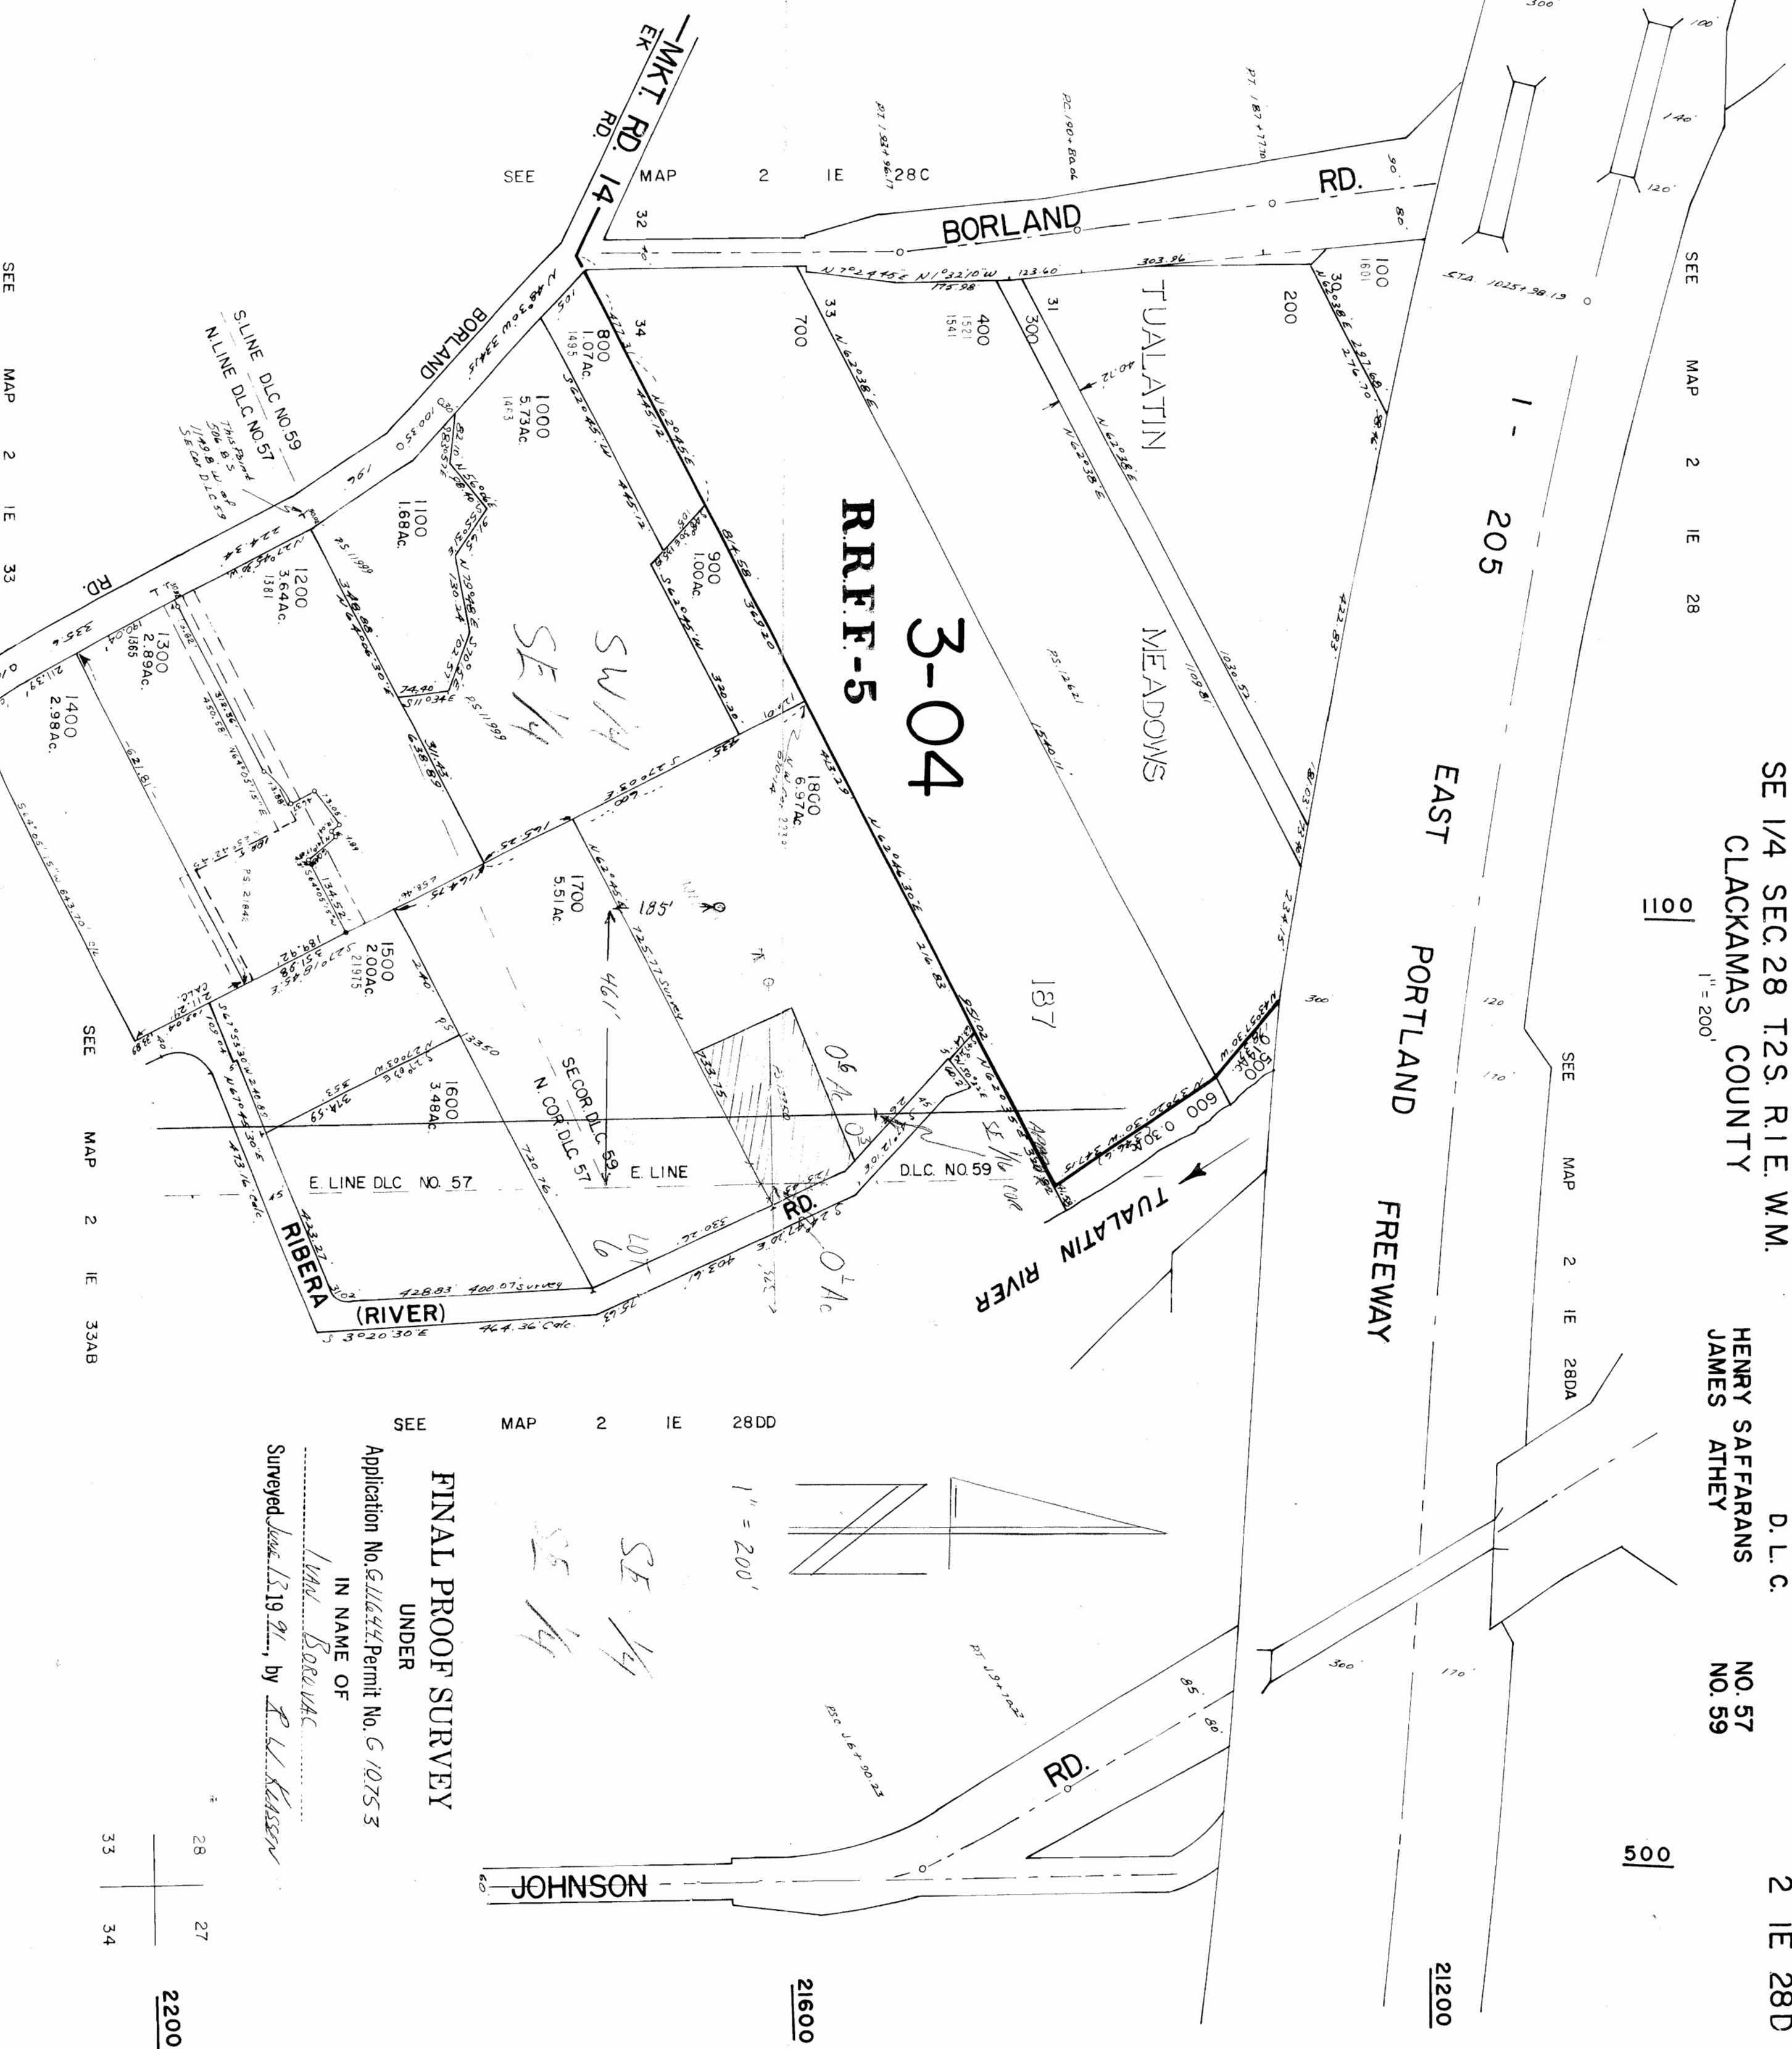

S LINE D.L.C. NO. 59
N LINE D.L.C. NO. 57

E LINE D.L.C. NO. 57

SE 1/4
SE 1/4

TBA
F.H.D.

2 IE 28D
BOOK 13