


T.5N.R.36E.W.M.

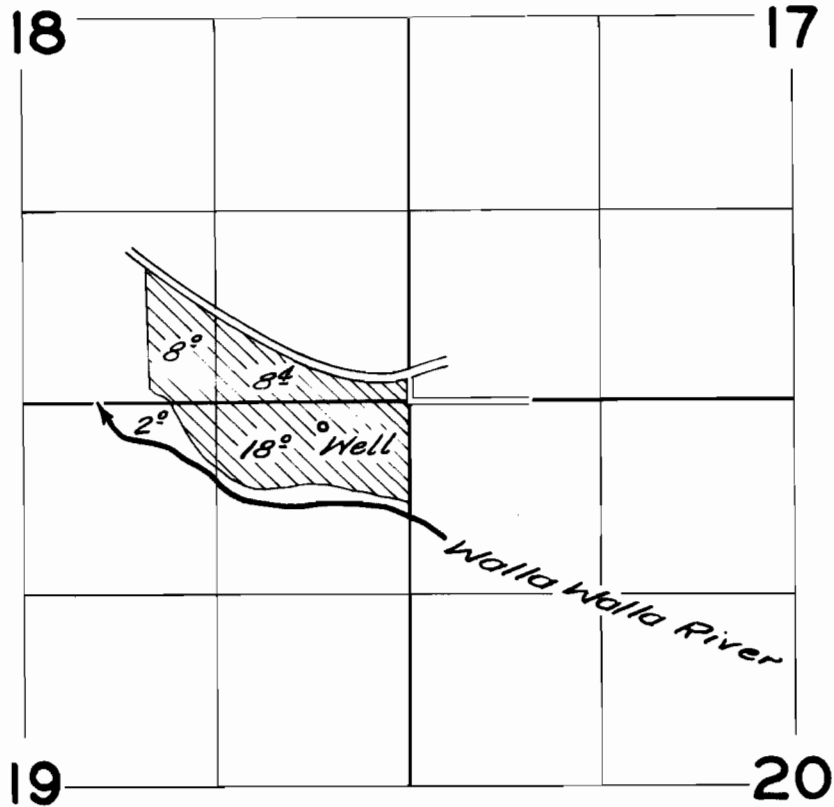

FINAL PROOF SURVEY

UNDER

Application No. G-424 Permit No. G-419

IN NAME OF

Archie Harris

Surveyed Oct. 26, 1959, by W. H. Smith