


# T. 35 S., R. 12 E., W.M.

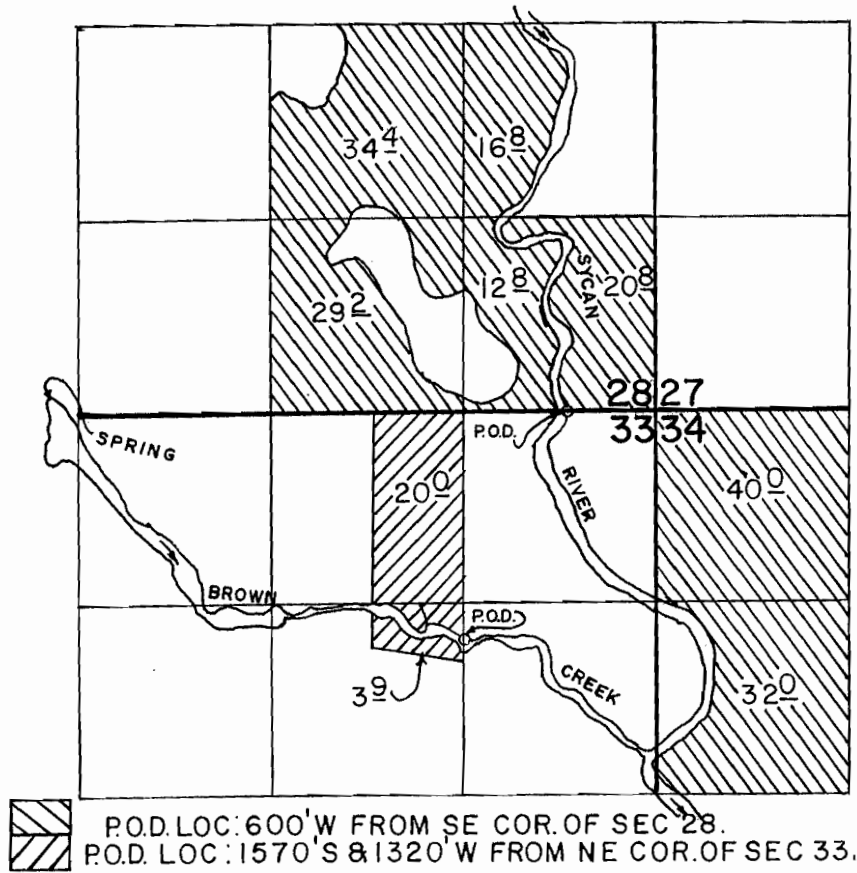

SCALE: 1" = 1320'

## FINAL PROOF SURVEY

UNDER

Application No. 61097      45475  
57268      Permit No. 43105  
 IN NAME OF



**RUSSELL J. WALSH & EDITH G. WALSH**

Surveyed JULY 26, 1994, by R.M.SUTTERFIELD