


T. 35 S., R. 12 E., W.M.

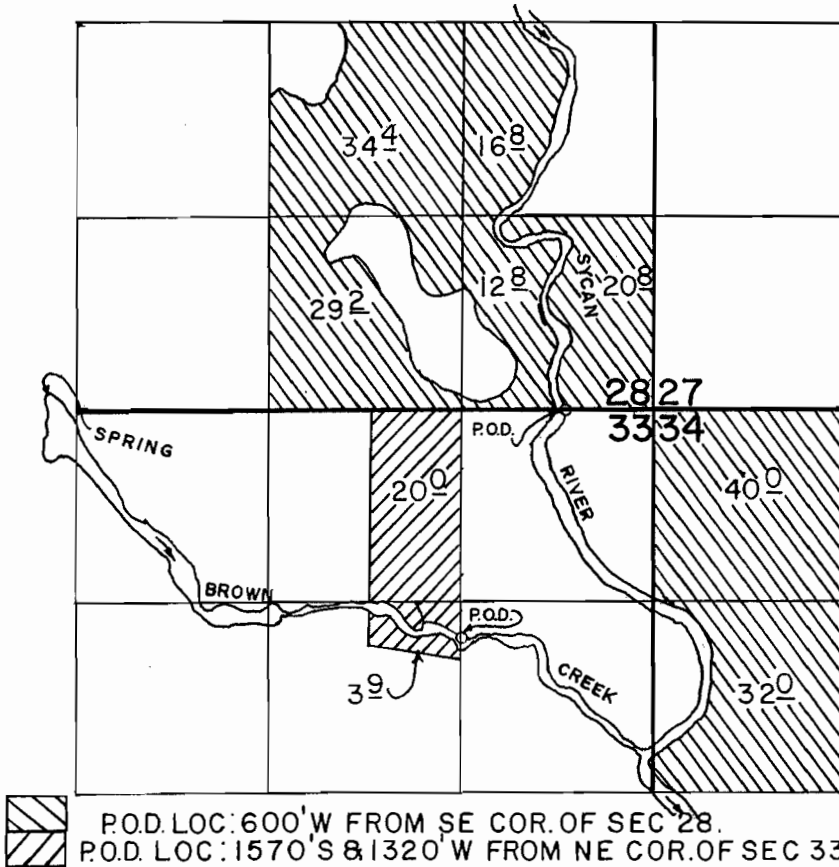

SCALE: 1" = 1320'

FINAL PROOF SURVEY

UNDER

Application No. 61097 Permit No. 45475
57268 43105
IN NAME OF



RUSSELL J. WALSH & EDITH G. WALSH

Surveyed JULY 26, 1994, by R.M.SUTTERFIELD