


T.35&36S.,R.12E.,W.M.

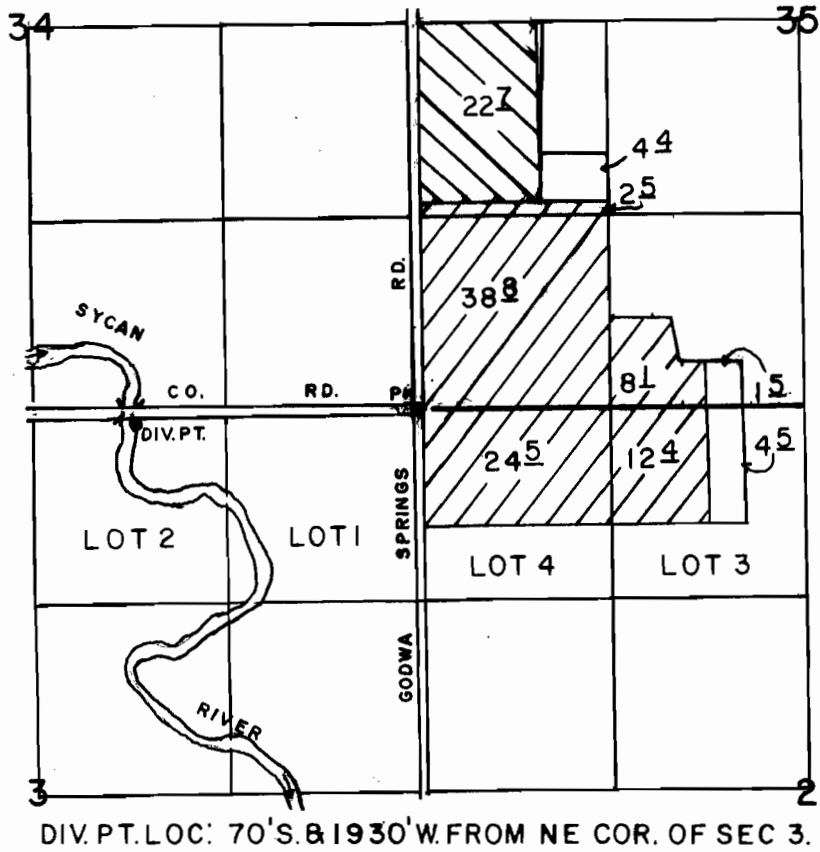

SCALE: 1" = 1320'

FINAL PROOF SURVEY
UNDER

Application No. 59250 68278 Permit No. 44513 49262 
IN NAME OF

THOMAS W. MALLAMS & BEVERLY S. MALLAMS

Surveyed JUNE 11 1991, by B. W. BISHOP.