


T. 39 S., R. 19 E., W.M.

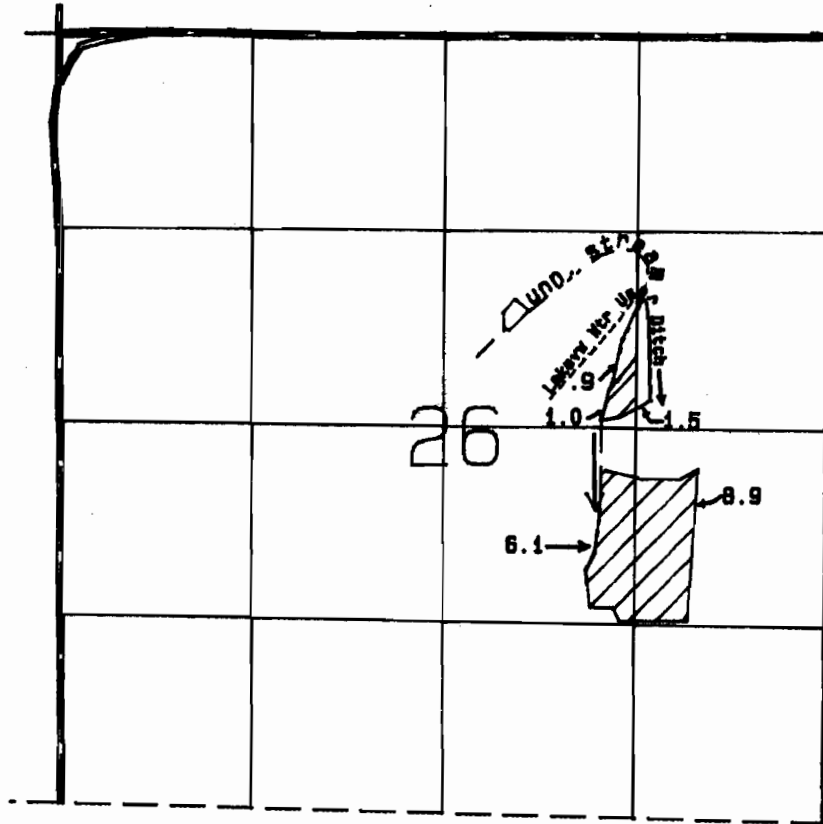

SCALE: 1 = 1320

DAM & DIV. PT. LOCATED 1850 FT. S. AND 2050 FT. W. FROM NE. SEC. COR. SEC. 26

FINAL PROOF SURVEY
UNDER

Application No. 56749 Permit No. 43882
R-56748 R-7791

IN NAME OF
J. Ed Long

Surveyed Oct. 17, 1987 By T.M. Warren

11/29/06 SWG
Photo: 379-82A RMK-618