


T.40 S., R.20 E., W.M.

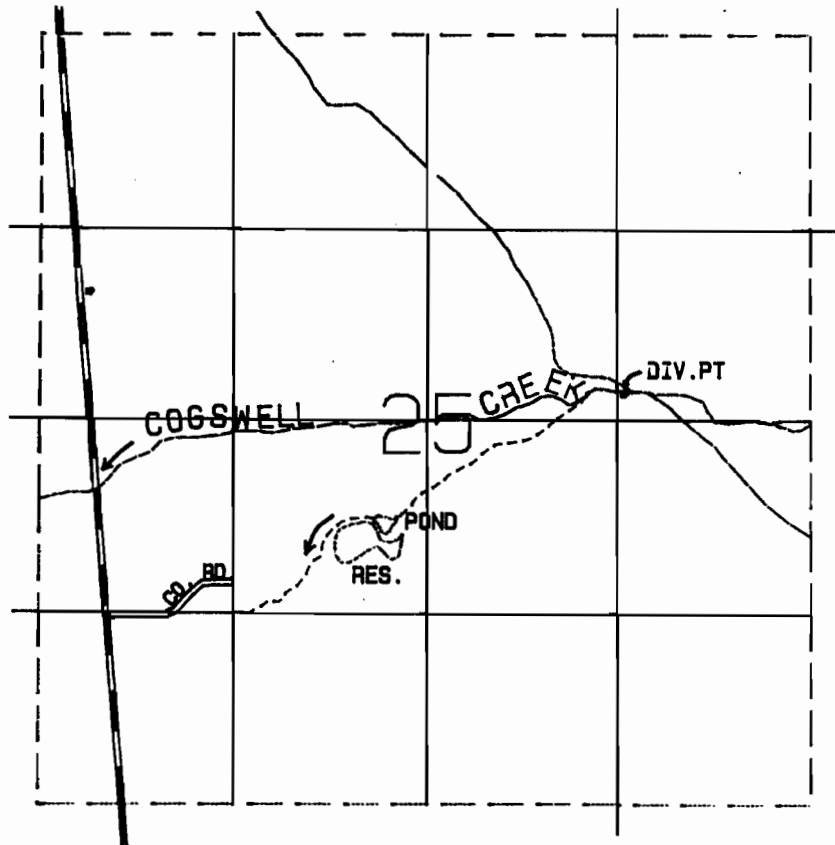

SCALE: 1 = 1320

DIV.PT. LOCATED 2480 FT. S. AND 4010 FT. E. FROM NW. COR. SEC. 25

FINAL PROOF SURVEY
UNDER

APPLICATION NO. R-68224 PERMIT NO. R-10399

APPLICATION NO. 68262 PERMIT NO. 49231

IN NAME OF
JIM CYR

Surveyed Oct. 15, 1987 By V.L. CHURCH

Photo: 379-169D JCL