


T. 40 S., R. 20 E., W.M.

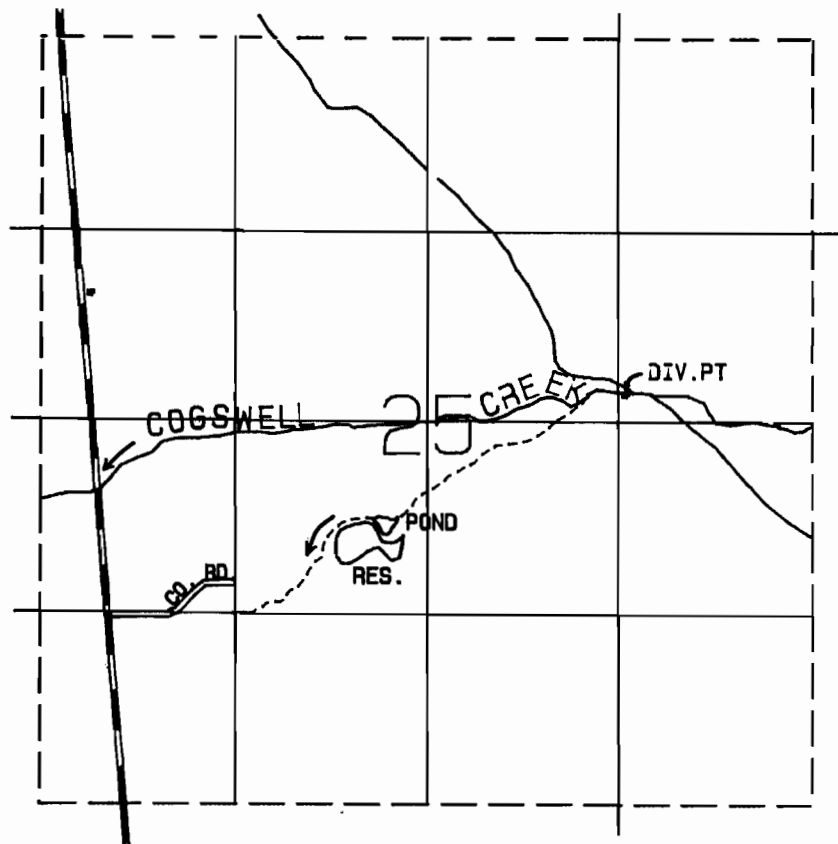

SCALE: 1 = 1320

DIV. PT. LOCATED 2480 FT. S. AND 4010 FT. E. FROM NW. COR. SEC. 25

FINAL PROOF SURVEY  
UNDER

APPLICATION NO. R-68224 PERMIT NO. R-10399

APPLICATION NO. 68262 PERMIT NO. 49231

IN NAME OF

JIM CYR

Surveyed Oct. 15, 1987 By V.L. CHURCH

Photo: 379-169D JCL