
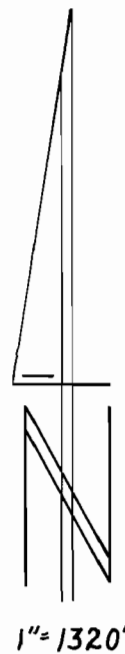


# T. 1 N., R. 4 E., W.M.

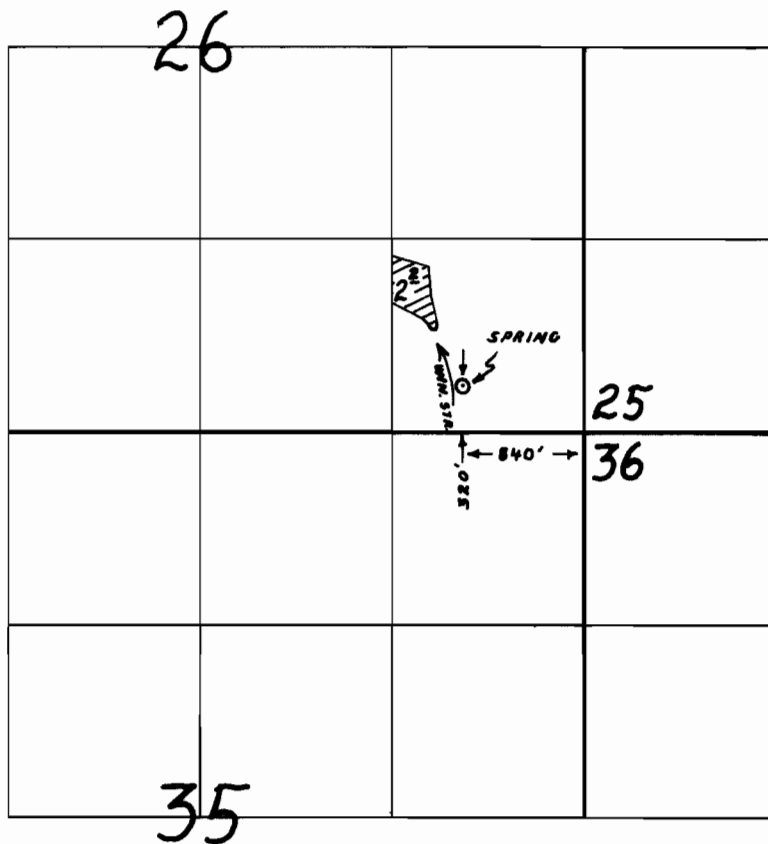

## FINAL PROOF SURVEY

UNDER

Application No. 54767 Permit No. 41083

IN NAME OF

GARY & TRACY JO CARPENTER

Surveyed OCTOBER 22, 1992, by R.W. Klassen