


Township 9 S., Range 22 E., W.M.

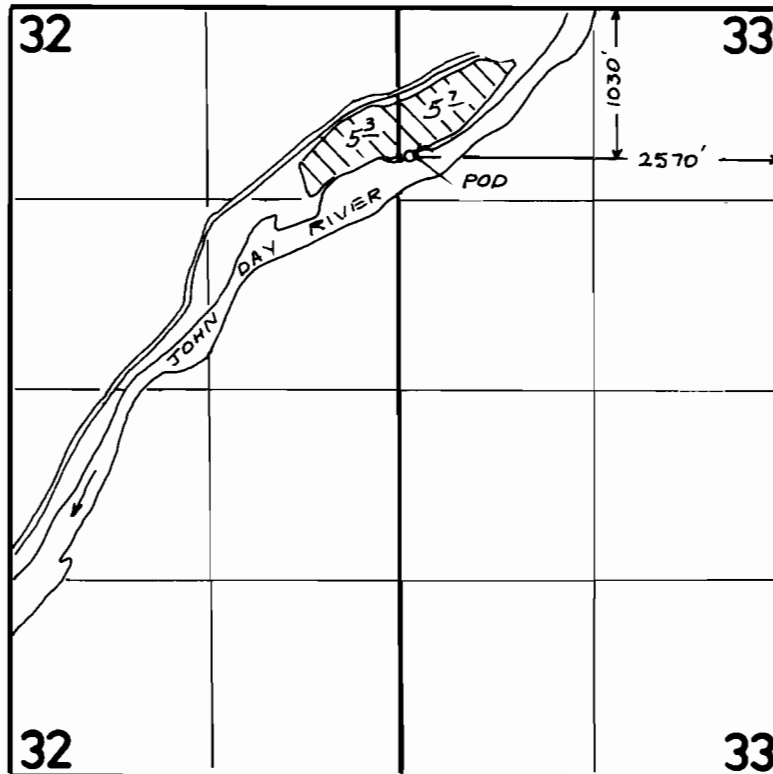

1"= 1320'

**FINAL PROOF SURVEY
UNDER**

Application No. 61734 Permit No. 45798
IN NAME OF

PARTNERS OF TWICKENHAM LIVESTOCK COMPANY

Surveyed May 20 99 by J. Miller
19....., by