


T. 30,31 S., R. 16 E., W.M.

SECTION 34
T. 30 S., R. 16 E., W.M.
SECTION 34

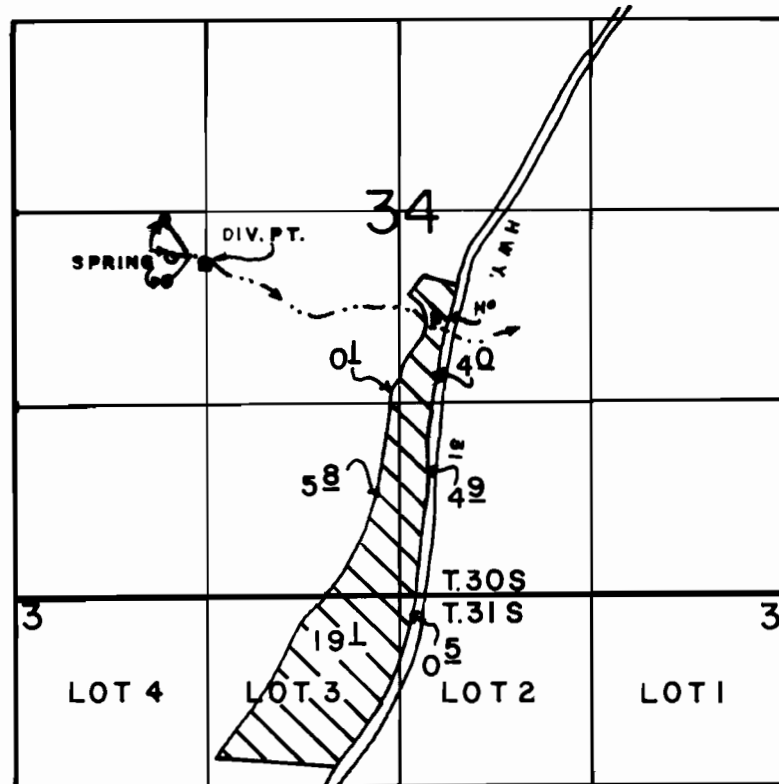

DIV. PT. LOC: 2300' N & 1280' E FROM SW COR. OF SEC 34.

SCALE: 1" = 1320'

FINAL PROOF SURVEY

UNDER

Application No. 64921 Permit No. 47716
IN NAME OF

ROBERT F. OLSON

Surveyed AUG 25, 1993, by R.M. SUTTERFIELD