


T. 32 S., R. 16 E., W.M.

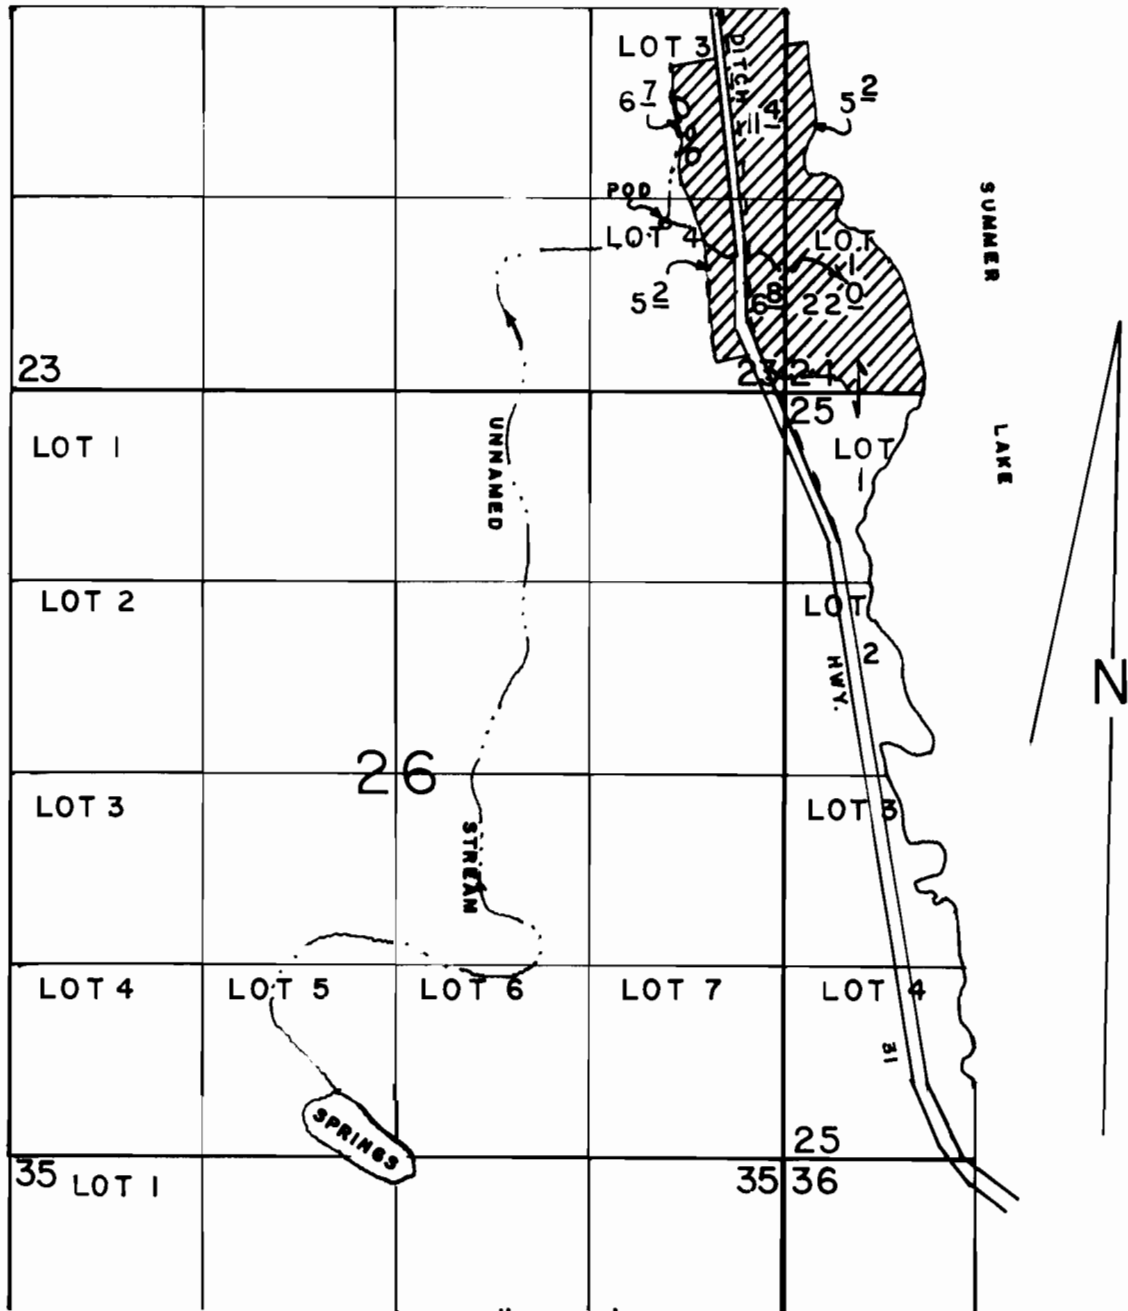

P.O.D. LOC: 1150' N & 820' W
FROM SE COR. OF SEC 23.

SCALE: 1" = 1320' FINAL PROOF SURVEY UNDER

Application No. 55146 Permit No. 41602
IN NAME OF

COLAHAN ENTERPRISES, INC.

Surveyed APRIL 13, 1994, by R.M. SUTTERFIELD