
 


T.6S. R.22E., W.M.

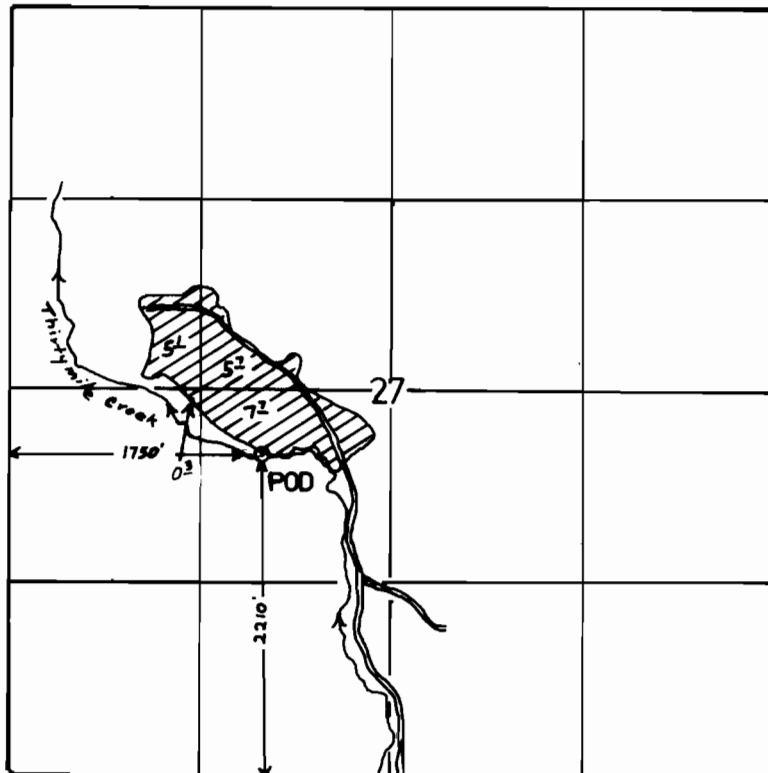

1" = 1320'

FINAL PROOF SURVEY
UNDER

Application No. 68346.. Permit No. 49428.....
IN NAME OF

.....KINZUA HILLS GOLF CLUB.....

Surveyed 1-30..... 1991... by K.KEMP.....