


T. 4 S., R. 2 E., W.M.

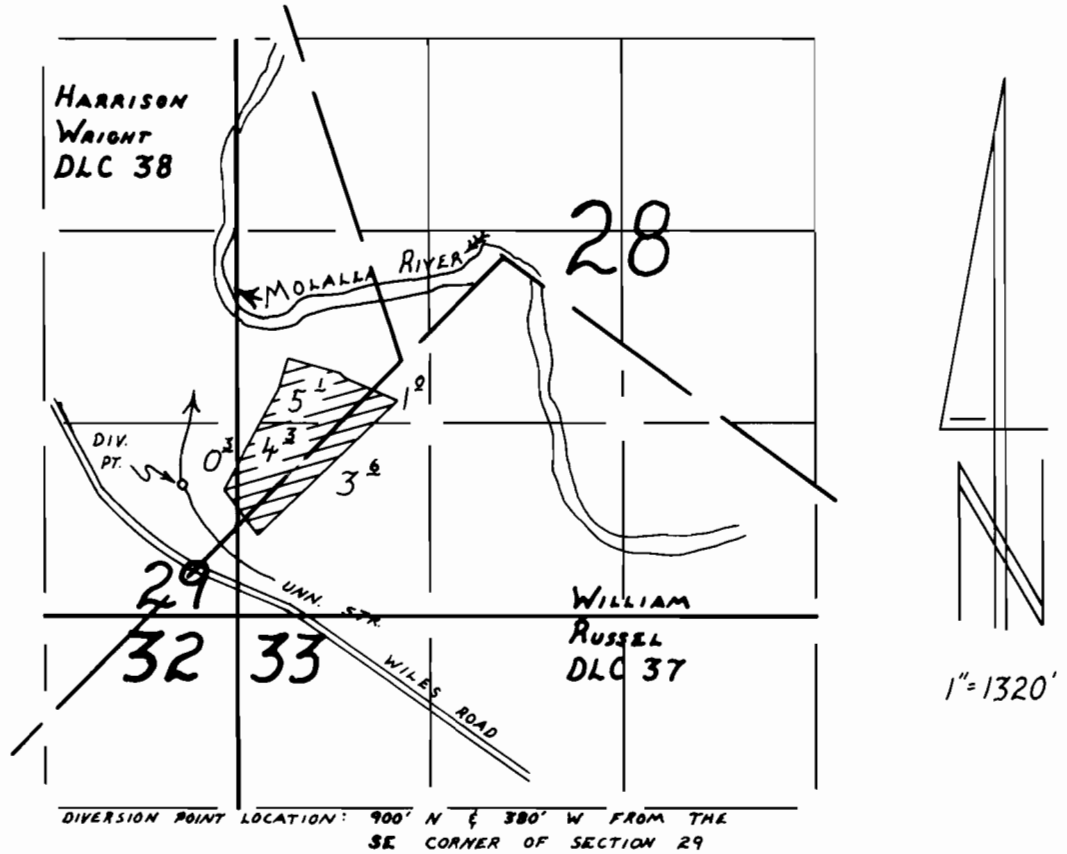

FINAL PROOF SURVEY

UNDER

Application No. 63574 Permit No. 47512
IN NAME OF

Terry P. Dugan

Surveyed April 25, 1994, by R.W. Klassen