


T. 2 N., R. 1 W., W.M.

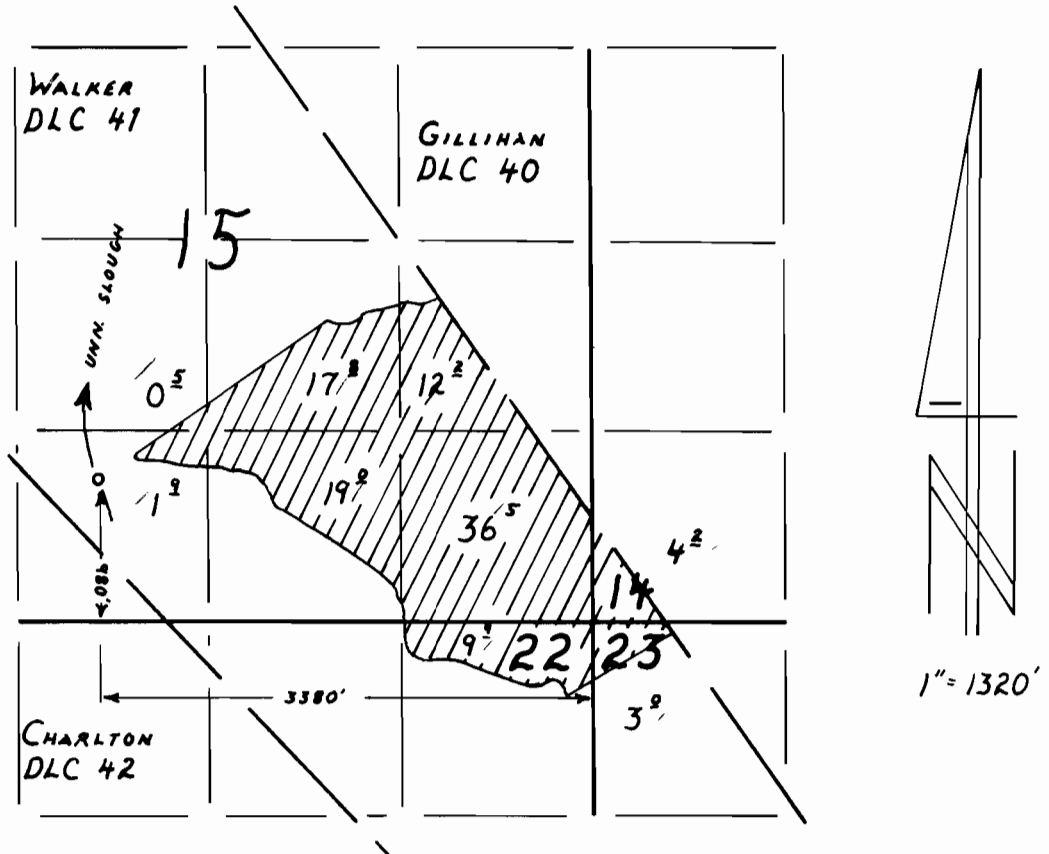

FINAL PROOF SURVEY

UNDER

Application No. 67108 Permit No. 48434
IN NAME OF

John E. & Dorothy Pearl Beall

Surveyed July 12, 1993, by R.W. Klassen