
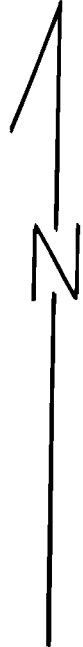


Township 9 South, Range 25 East, W. M.

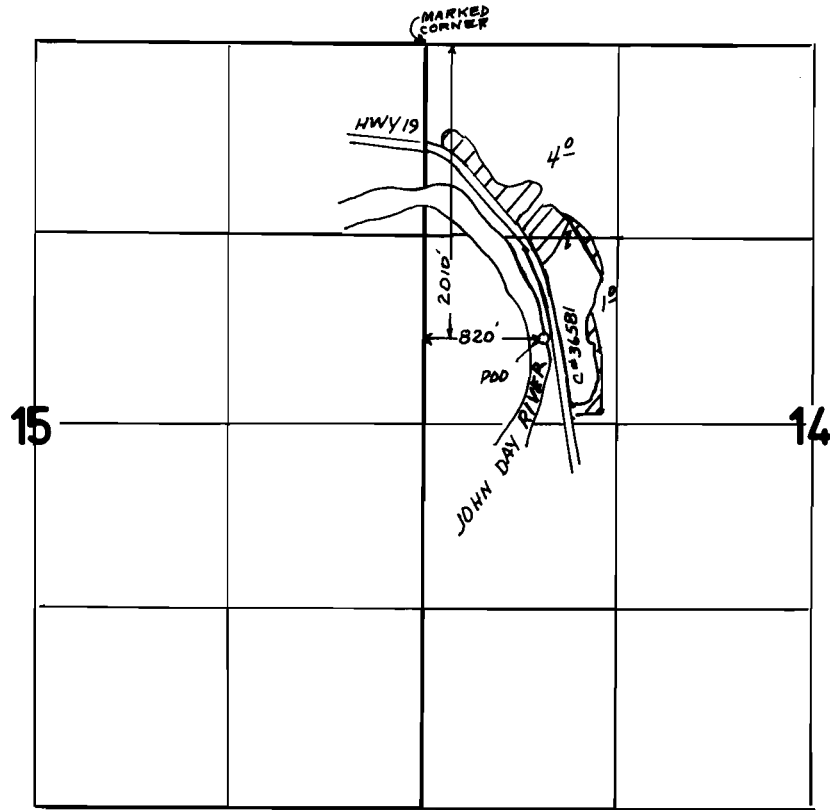

1" = 1320'

FINAL PROOF SURVEY
UNDER

Application No. 56.719.. **Permit No.** 48.118.....
IN NAME OF

.....JEAN..HILL.....

Surveyed 7.-25... 2000., **by** J..MILLER.....