
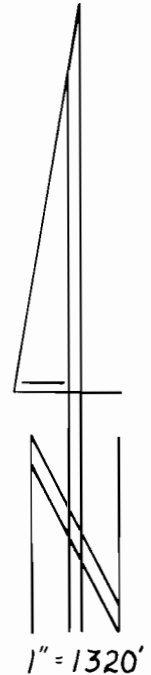


T. 2 S., R. 6 E., W.M.

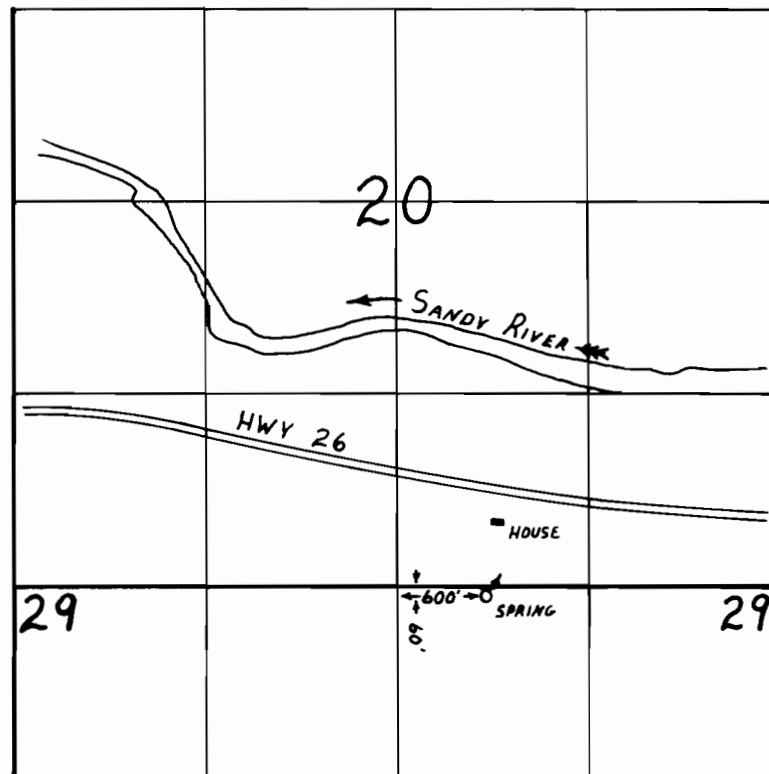

FINAL PROOF SURVEY

UNDER

Application No. 63316 Permit No. 46717
IN NAME OF

E.W. MORLAN

Surveyed AUGUST 21, 1992, by R.W. Klassen