


T. 5 S., R. 28 E., W.M.

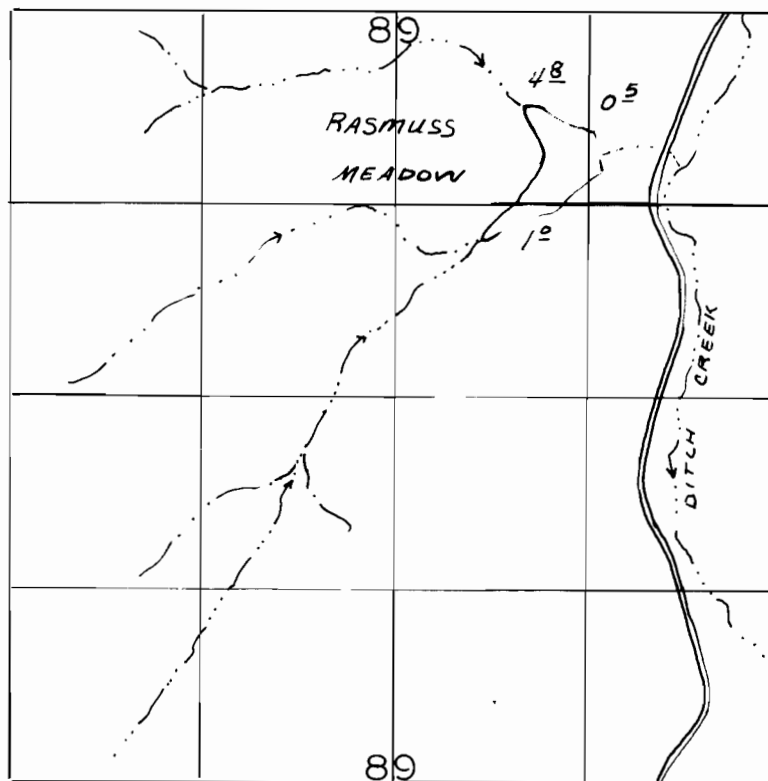

1" = 1320'

FINAL PROOF SURVEY

UNDER

Application No. R-57325 Permit No. R-7820
IN NAME OF

O. W. CUTSFORTH

Surveyed 9-10, 1993, by J. MILLER