


T. 34S., R. 19E., W.M.

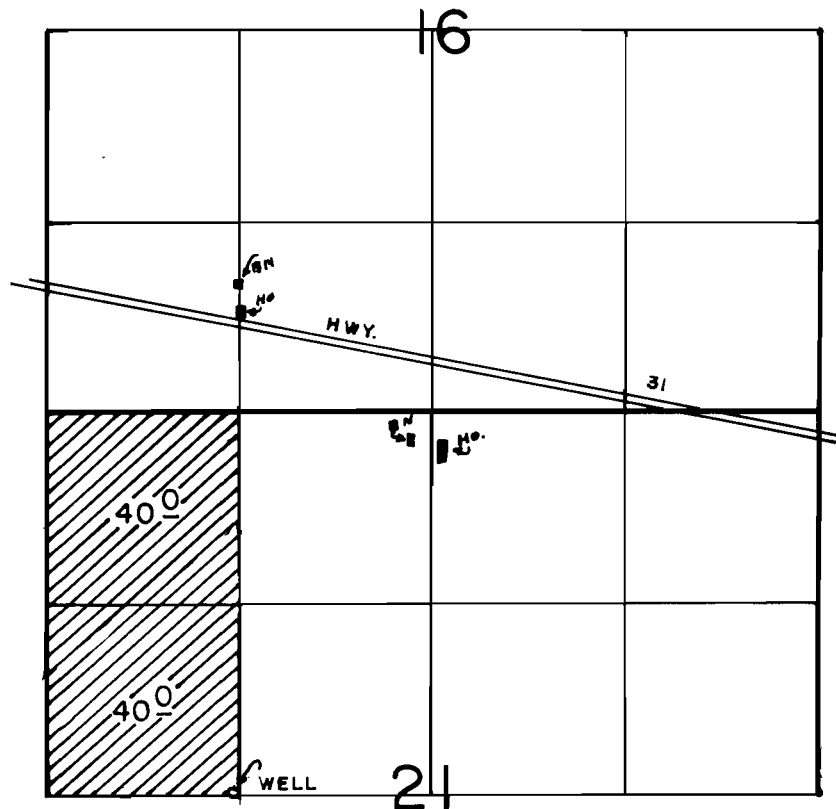

WELL LOC: 2630' S & 1280' E FROM NW COR. OF SEC 21.

SCALE: 1" = 1320'

FINAL PROOF SURVEY

UNDER

Application No. G-11653 Permit No. G-10926
IN NAME OF

J-SPEARS RANCH COMPANY

Surveyed SEPT 7, 1994 by R.M. SUTTERFIELD