


T. 2N., R. 3E., W.M.

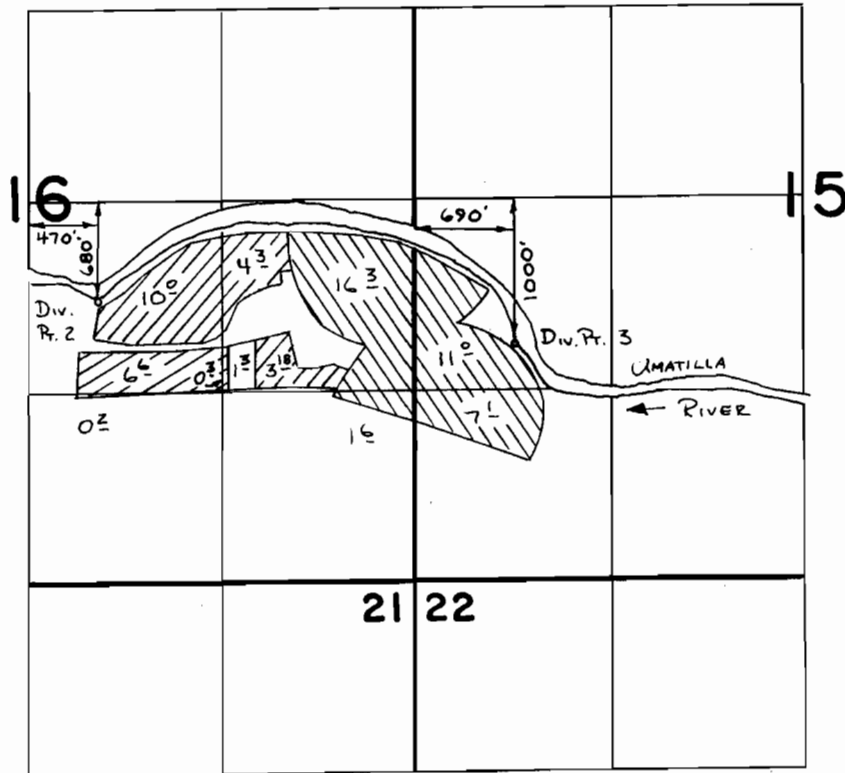

SCALE 1" = 1320'



T-5773
Div. Pr. 3



T-5774
Div. Pr. 2



T-5794
Div. Pr. 2

FINAL PROOF SURVEY
UNDER

TRANSFERS 5774, 5773, 5794
IN NAME OF

.....**LEWIS LIVESTOCK**.....**INC.**.....

Surveyed 11.7..... 1988., by V.A. Church.....