


SEC 6 T10S R5W WM  
POLK COUNTY  
SCALE = 400'

10 5 6

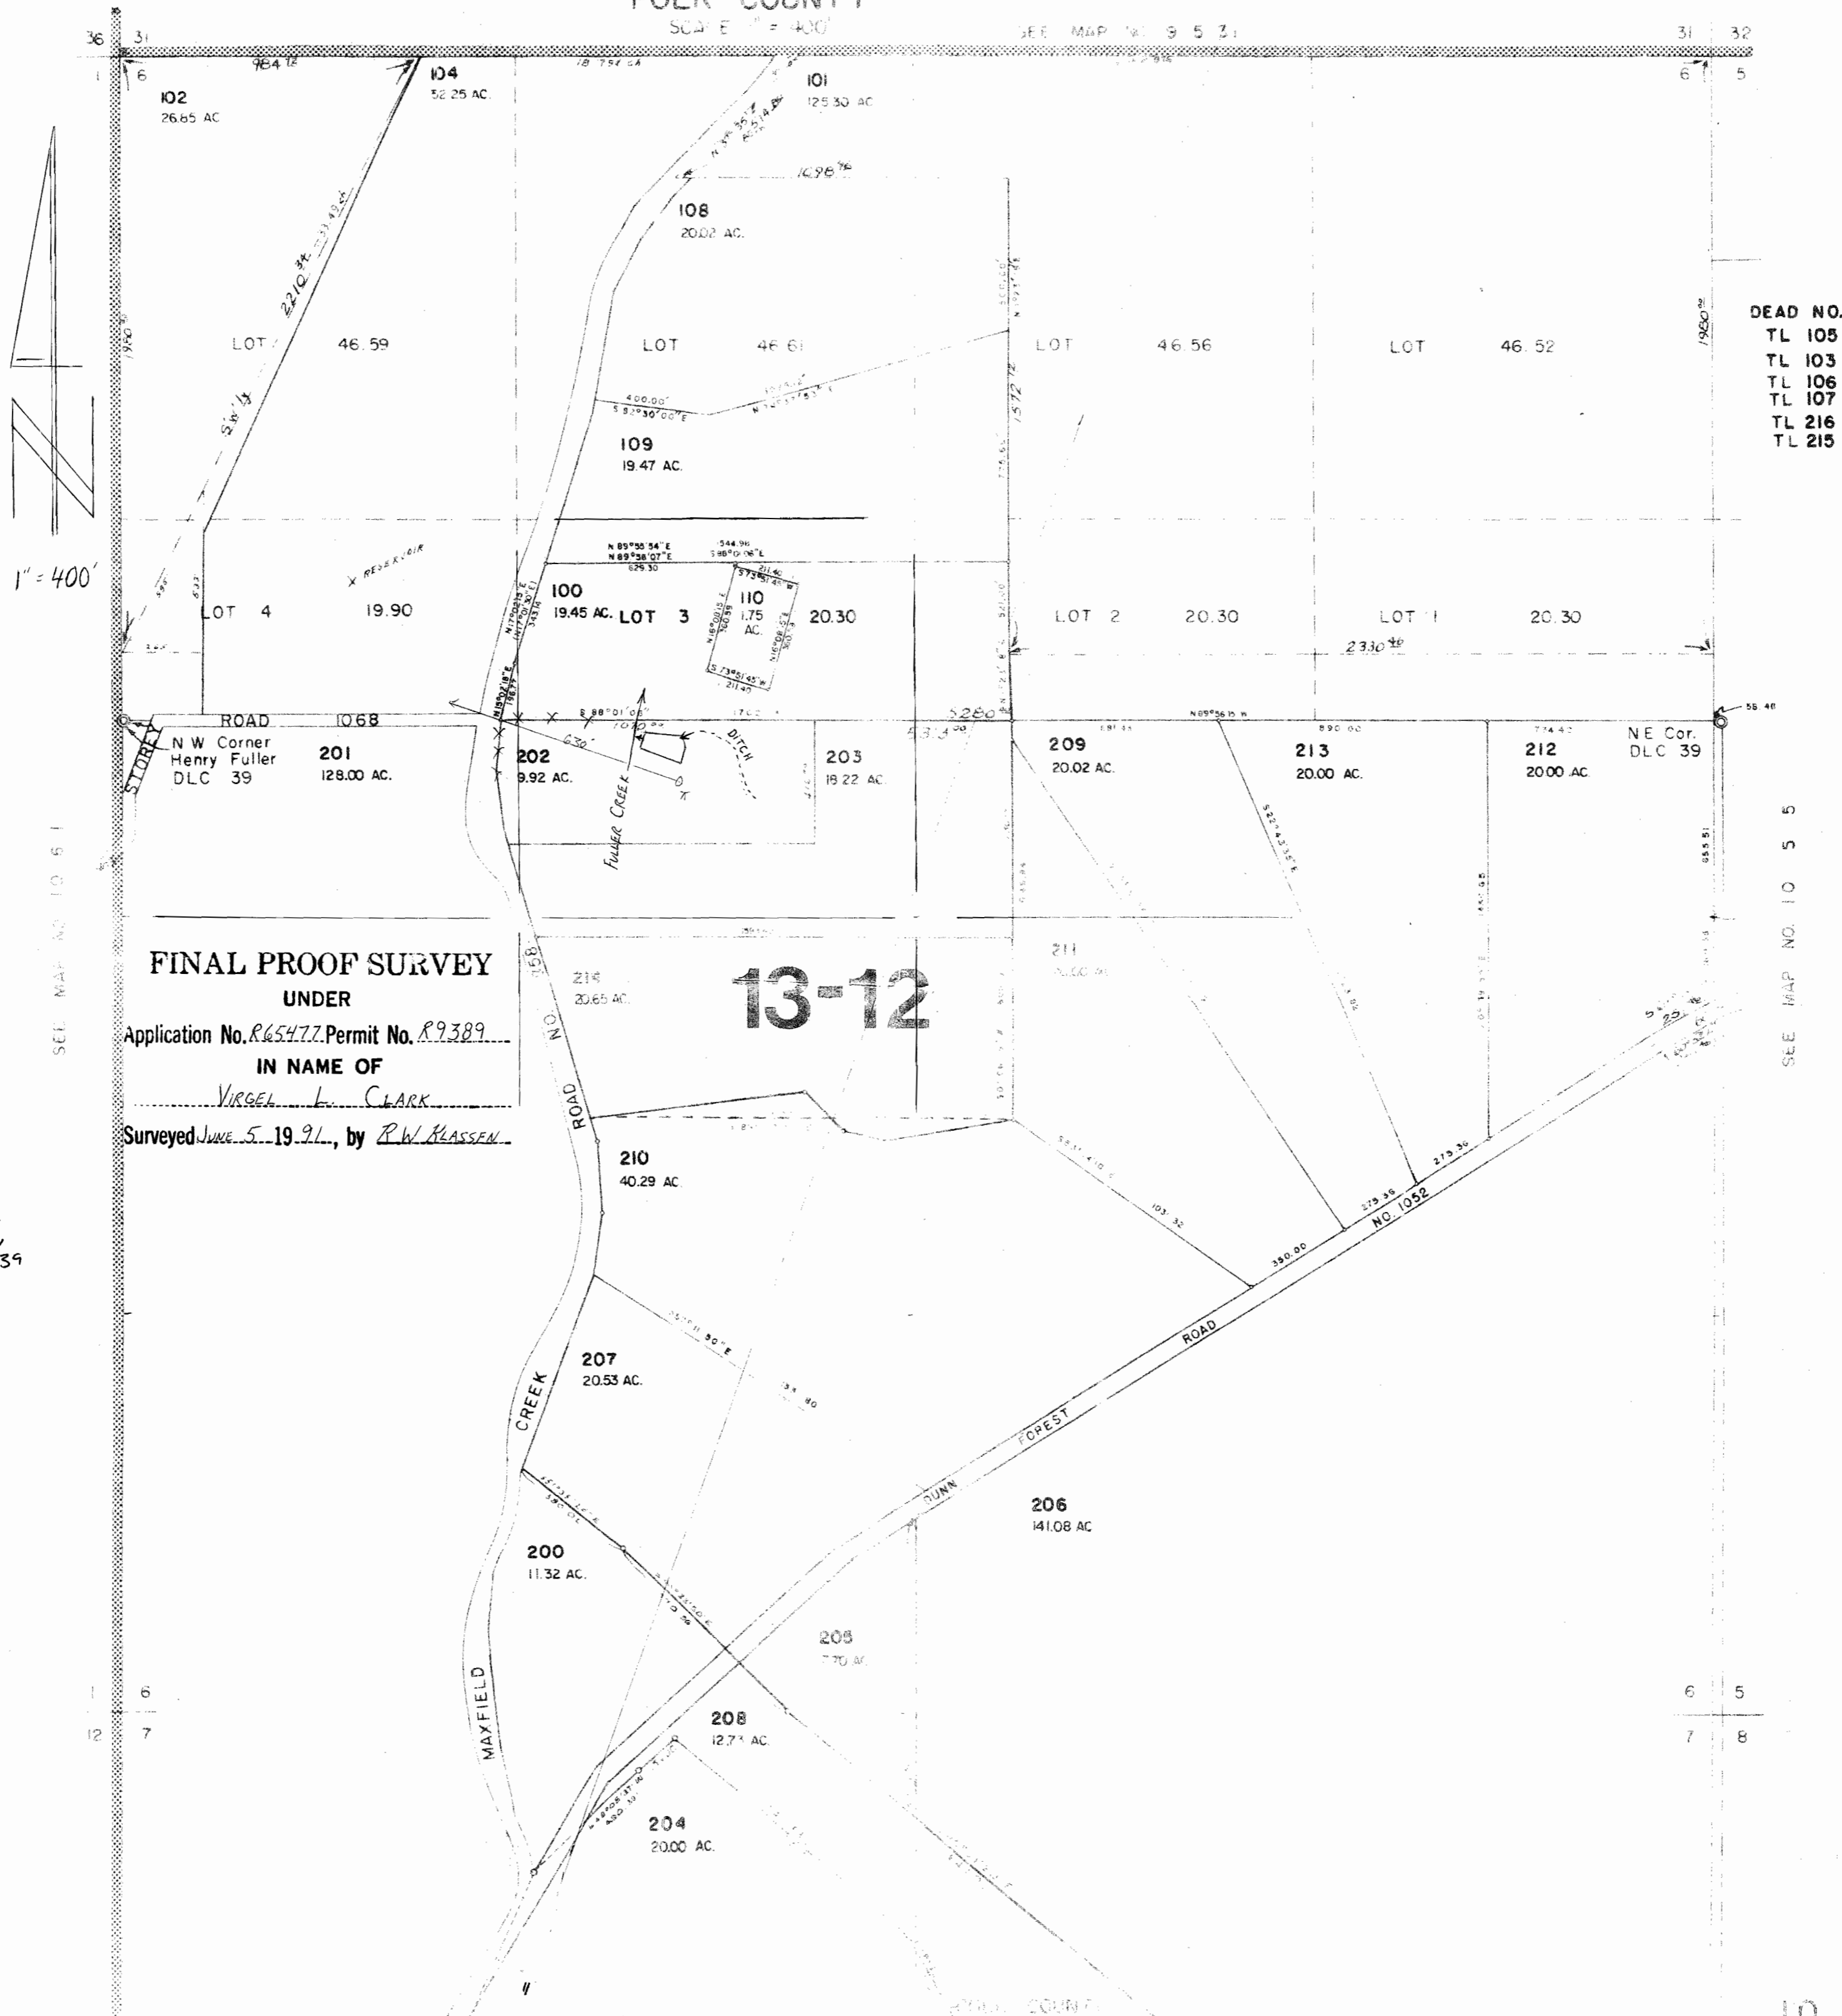

DEAD NO.  
TL 105  
TL 103  
TL 106  
TL 107  
TL 216  
TL 215

FINAL PROOF SURVEY  
UNDER  
Application No. R65477 Permit No. R9389  
IN NAME OF  

13-12

POD: 65' S & 1730' E,  
NW CORNER DLC 39

APPROXIMATE DAM LOCATION:  
60' S & 1630' E,  
NW CORNER DLC 39

July  
12/10/06

10 5 6