


Township 9 & 10 S., Range 22 E., W.M.

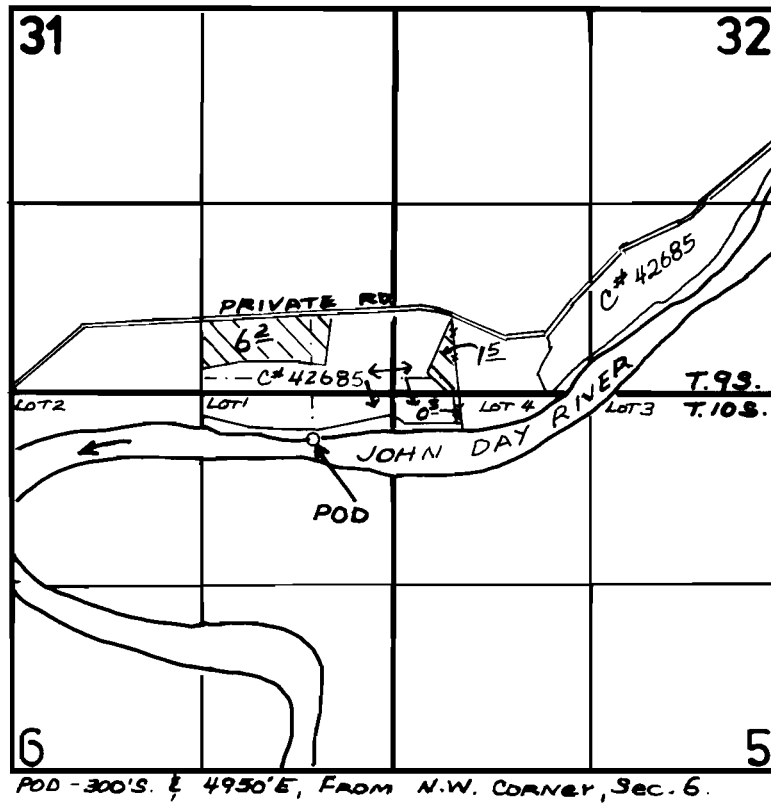

1"= 1320'

**FINAL PROOF SURVEY
UNDER**

Application No. 65099 Permit No. 47573
IN NAME OF

ZACK T. and LINDA K. KEYS
.....

Surveyed May 20, 19..99, by ..J. Miller.....