


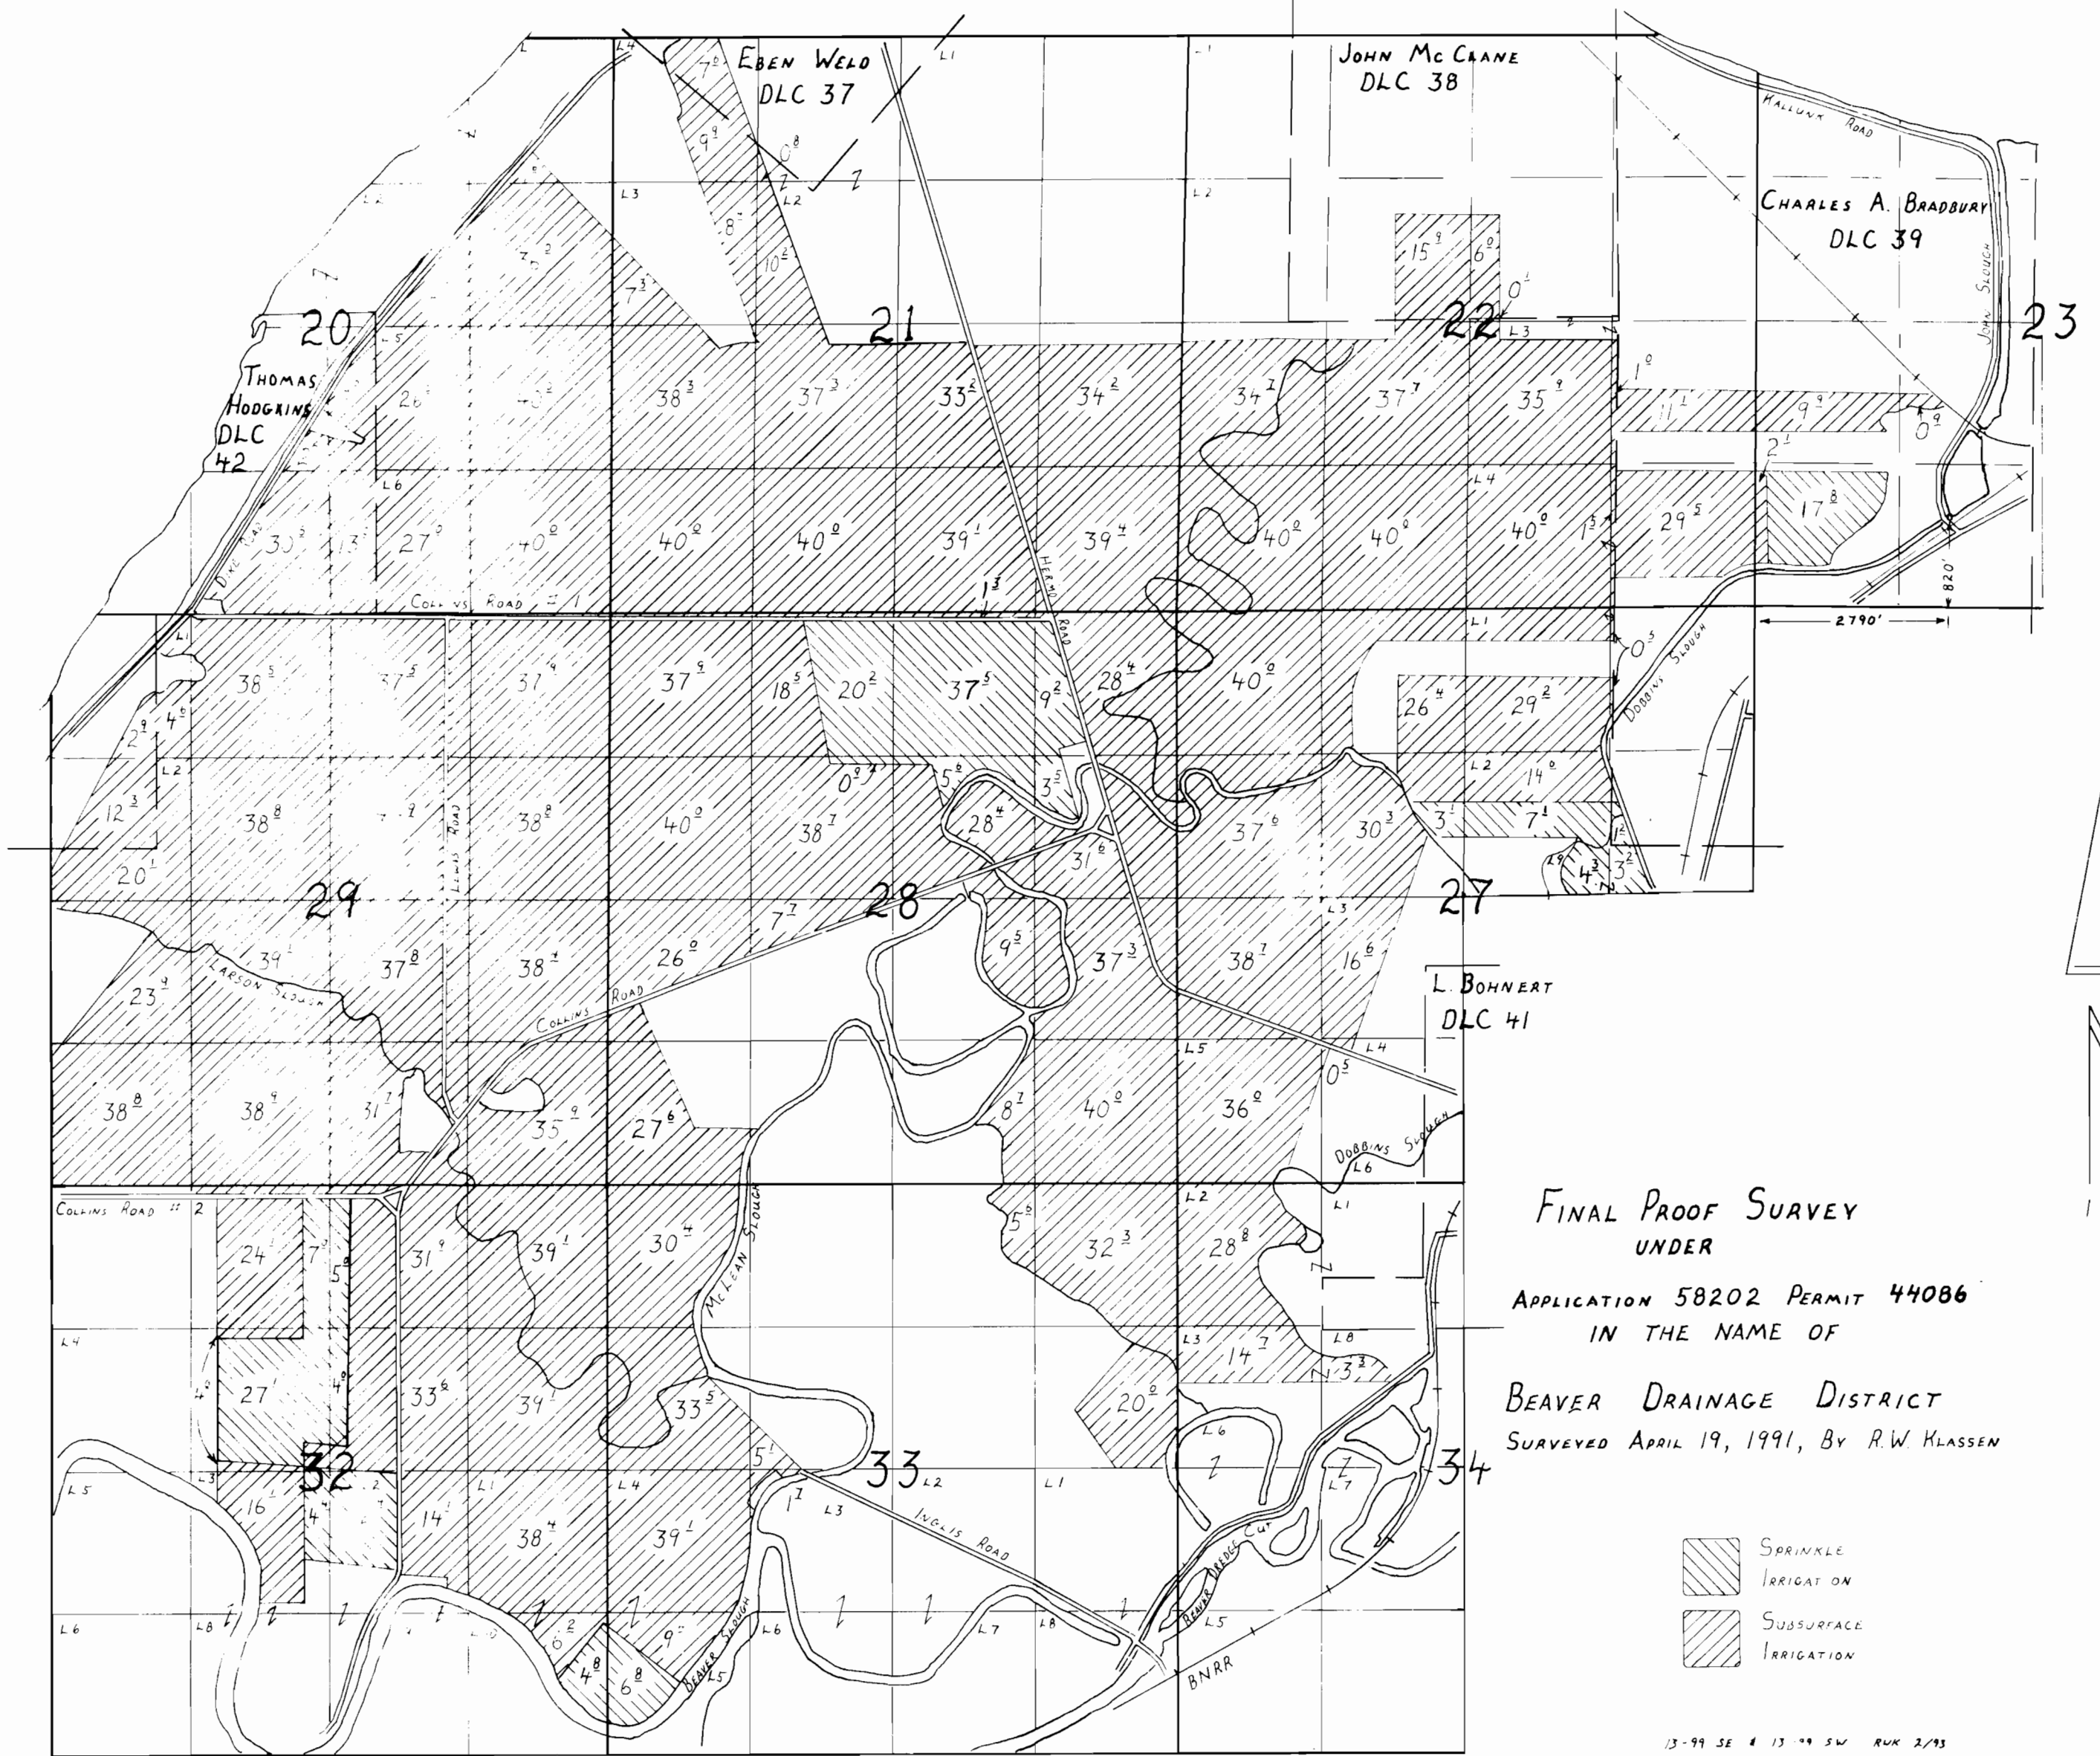

TOWNSHIP 8 NORTH, RANGE 4 WEST, W.M.



FINAL PROOF SURVEY
UNDER

APPLICATION 58202 PERMIT 44086
IN THE NAME OF

BEAVER DRAINAGE DISTRICT
SURVEYED APRIL 19, 1991, BY R.W. KLASSEN

-  SPRINKLE IRRIGATION
-  SUBSURFACE IRRIGATION

13-99 SE & 13-99 SW RUK 2/93

