


TOWNSHIP 9 SOUTH, RANGE 23 EAST, W.M.

FND BC

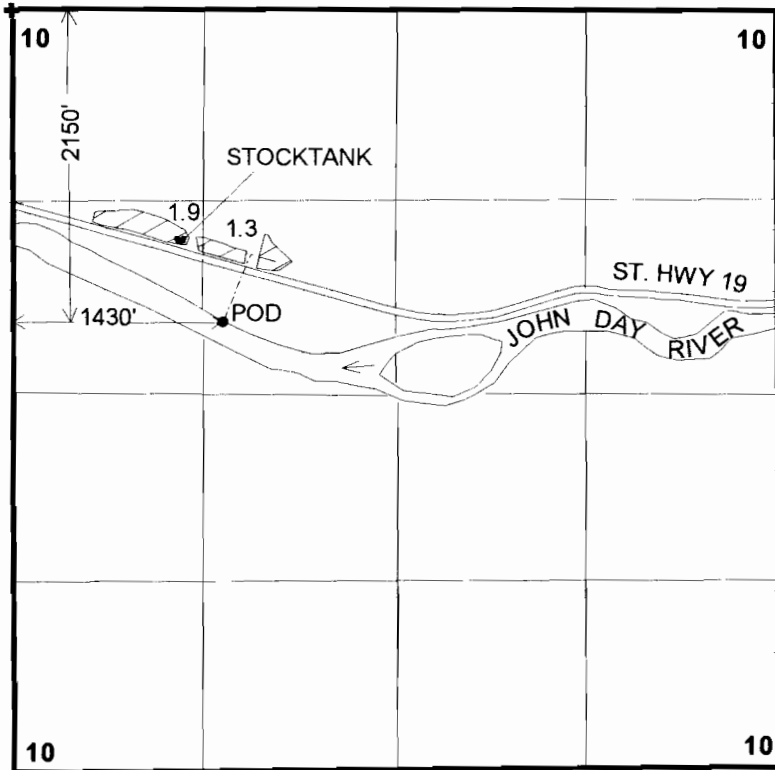

1" = 1320'

FINAL PROOF SURVEY
UNDER
Application No. 63829 Permit No. 47415
IN THE NAME OF

Surveyed April 26, 2001 by June Miller

RECEIVED

DEC 02 2002

WATER RESOURCES DEPT.
SALEM, OREGON

NAPP 1210 64R JM 11-19-2002